

Sunflower
 Q 42
 4-67

MISSISSIPPI
 BOARD OF WATER COMMISSIONERS
 416 North State Street
 Jackson, Mississippi 39201
 WATER WELL DRILLERS LOG

8/3/67
 Jm
 C2440

April 26, 1967 Layne-Central Company Sunflower
 date well completed firm name county well located

LANDOWNER: William Ervin

description of formations encountered

from to

Clay	0	18
Fine sand	18	40
Coarse sand, pea gravel	40	60
Coarse sand, gravel	60	102

Inverness, Mississippi
 (mailing address)

WELL LOCATION:


sec. 31 T. 18 N. R. 4 E
 S. W.

_____ miles of Inverness
 (distance) (direction) (nearest town)

WELL PURPOSE: irrigation
 (home, irrigation, municipal, industrial)

WELL COMPLETION DATA:


- (1) diameter (inches) 12
- (2) total depth (feet) 102
- (3) static water level (feet) 19' 2" ~~below~~ above top of ground.
- (4) casing steel, 72' (material), (depth),
 12" (size) if telescope see back.
- (5) screen 30' (length), 102' (depth to top)
 12" (size), Arceo (material)
- (6) pump 30 (HP), 1352 (yield gpm)
 engine (type power)
- (7) electric log no (yes or no)
 (organization running log)
- (8) how well bottom plugged plate

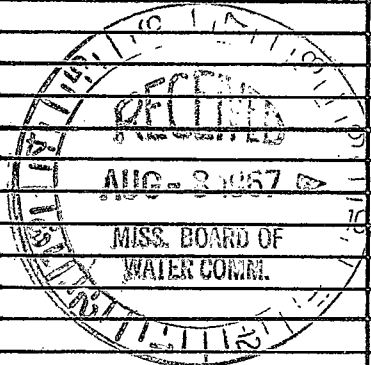

DRILLERS REMARKS:

If well telescopes please sketch and show depths.

GROUND LEVEL

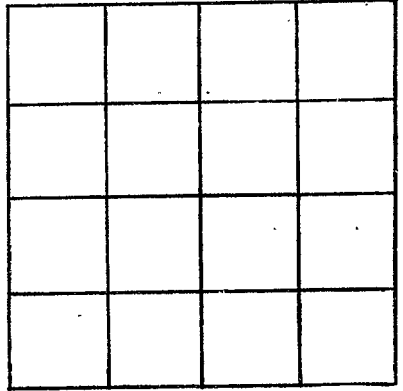

SECTION 31

Please indicate well location X.

ADDITIONAL INFORMATION

If more than one screen, show locations of each on sketch.