

SUNFLOWER

Q43

7-18-79

MISSISSIPPI BOARD OF WATER COMMISSIONERS 416 North State Street Jackson, Mississippi 39201

CODED

WATER WELL DRILLERS LOG

7-18

19

79 Larry's Well Pump Sunflower

date well completed

firm name

county well located

LANDOWNER: Bill Long

Inverness Miss

(mailing address)

WELL LOCATION:

sec. 19 T. 18 N

R

4 E W

4 West miles 3 north, Inverness (distance) (direction) (nearest town)

WELL PURPOSE: fish pond (home, irrigation, municipal, industrial)

CODED

WELL COMPLETION DATA:

- (1) diameter (inches) 12"
(2) total depth (feet) 112 1/2
(3) static water level (feet) 17 below top of ground.
(4) casing steel 74' (material) (depth)
(5) screen 20 74' (length) (depth to top)
(6) pump 30 2000 (HP) (yield gpm)
(7) electric log (yes or no)

Table with 3 columns: description of formations encountered, from, to. Rows include clay, coarse sand, coarse sand, coarse sand, coarse sand.

(organization running log)

(8) how well bottom plugged Steel Plate

DRILLERS REMARKS:


Miss. Board of Water Comm.

AUG 21 1979

RECEIVED

If well telescopes please sketch and show depths.

GROUND LEVEL

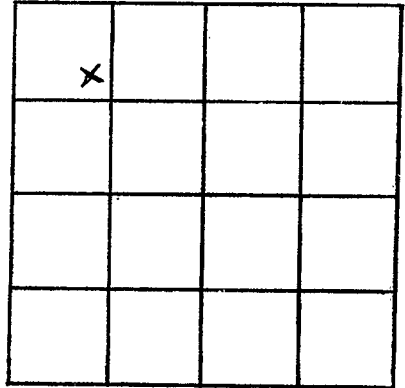

SECTION 19

Please indicate well location X.

ADDITIONAL INFORMATION

If more than one screen,  
show locations of each on sketch.