

Sunflower

-Q-45

8-28-80

MISSISSIPPI
 BOARD OF WATER COMMISSIONERS
 416 North State Street
 Jackson, Mississippi 39201

3059
 CODED

WATER WELL DRILLERS LOG

8/28
 date well completed

1980 Dyer Well + Irrigation
 firm name

Sunflower
 county well located

LANDOWNER:

TRANS FISHERIES
 RR1 Box 51
 YAZOO CITY MISS 39194
 (mailing address)

description of formations encountered

from to

Clay	0	30
Fine Sand	30	63
Sand & Gravel	63	83
Fine Sand	83	95
Sand + Gravel	95	118

WELL LOCATION:

sec. 14 T. 16(N) S. R. 4 E
 5 1/2 miles West of Moorhead
 (distance) (direction) (nearest town)

WELL PURPOSE: Irrigation
 (home, irrigation, municipal, industrial)

WELL COMPLETION DATA:

- (1) diameter (inches) 16"
- (2) total depth (feet) 118'
- (3) static water level (feet) 23' below top of ground.
- (4) casing STEEL 78' (material) (depth)
- 16" (size) if telescopic see back.
- (5) screen 40' 78' (length) (depth to top)
- 16" (size) STEEL (material)
- (6) pump 60 3,000 (HP) (yield gpm)
- DIESEL (type power)
- (7) electric log No (yes or no)
- (organization running log)

DEPT. OF NATURAL RESOURCES
 BUREAU OF LAND & WATER RESOURCES


SEP 12 1980

RECEIVED

DRILLERS REMARKS:

Plate

GROUND LEVEL

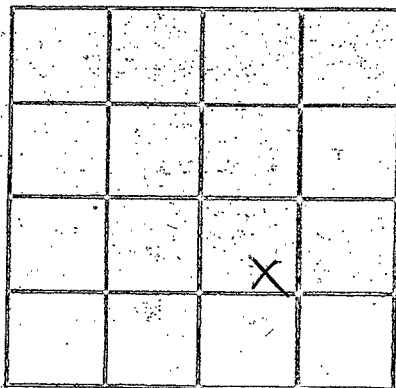

SECTION _____

Please indicate well location X.

ADDITIONAL INFORMATION

If more than one screen,
show location of each on sketch.