

MISSISSIPPI DEPARTMENT OF NATURAL RESOURCES

Bureau of Land and Water Resources

Southport Mall

P.O. Box 10631

Jackson, Mississippi 39209

WATER WELL DRILLERS LOG

CODED

SUNFLOWER
Q 46
8/21/80

8/21 1980 DYER WELL & IRR SUNFLOWER
 date well completed firm name county well located

LANDOWNER:
ROGER BRASHIER
INDIANOLA, MISS
 (mailing address)

description of formations encountered	from	to
CLAY	0	28
FINE SAND	28	38
SAND	38	68
CLAY & FINE SAND	68	80
SAND & GRAVEL	80	123

WELL LOCATION:
 sec. 12 T. 18 N. R. 4 E
4 miles SW of MOOREHEAD
 (distance) (direction) (nearest town)

WELL PURPOSE:
 (home, irrigation, municipal, industrial)

WELL COMPLETION DATA:

(1) diameter (inches) 16

(2) total depth (feet) 123

(3) static water level (feet) 20 below above top of ground.

(4) casing STEEL 83
 (material) (depth)

16 If telescope see back.
 (size)

(5) screen 40 83
 (length) (depth to top)

16 STEEL
 (size) (material)

(6) pump 60 2800
 (HP) (yield gpm)

DIESEL
 (type power)

(7) electric log NO
 (yes or no)

(organization running log)

(8) how well bottom plugged STEEL
PLATE

DRILLERS REMARKS:

CODED


DEPT. OF NATURAL RESOURCES
 BUREAU OF LAND & WATER RESOURCES

OCT - 1 1980

RECEIVED

If well telescopes please
sketch and show depths.

GROUND LEVEL

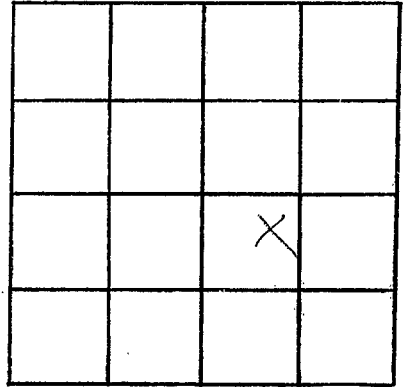

SECTION 12

Please indicate well location X.

ADDITIONAL INFORMATION

If more than one screen,
show locations of each on sketch.