

SUNFLOWER
 Q 47
 43/80

MISSISSIPPI
 BOARD OF WATER COMMISSIONERS
 416 North State Street
 Jackson, Mississippi 39201

15
 CODED

WATER WELL DRILLERS LOG

6/3 1980 DYER WELL & IRR SUNFLOWER
 date well completed firm name county well located

LANDOWNER: TRANSFISHERIES
 R.R. 1 - Box 51
 YAZOO CITY - MISS 39194
 (mailing address)

description of formations encountered	from	to
CLAY	0	23
SAND	23	33
SAND & GRAVEL	33	93

WELL LOCATION:
 sec. 13 T18 N R 4 E
 S NW of MARKHAM
 (distance) (direction) (nearest town)

WELL PURPOSE:
 (home, irrigation, municipal, industrial)

CODED

WELL COMPLETION DATA:

- (1) diameter (inches) 16
- (2) total depth (feet) 93
- (3) static water level (feet) 22 ^{below} top of ground
- (4) casing STEEL, 53 (material), (depth)
 16 If telescope see back. (size)
- (5) screen 40, 53 (length), (depth to top)
 16 STEEL (size), (material)
- (6) pump 60, 2800 (HP), (yield gpm)
 DIESEL (type power)
- (7) electric log NO (yes or no)

DEPT. OF NATURAL RESOURCES
 BUREAU OF LAND & WATER RESOURCES

OCT 14 1980


RECEIVED

(organization running log)
 (8) how well bottom plugged STEEL PLATE

DRILLERS REMARKS:

If well telescopes please sketch and show depths.

GROUND LEVEL

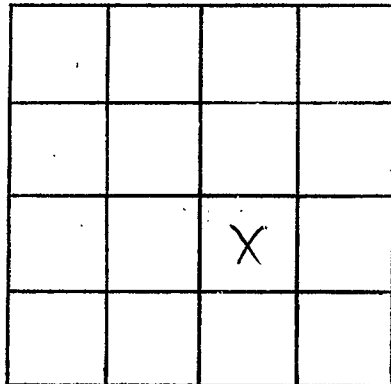

SECTION 13

Please indicate well location X.

ADDITIONAL INFORMATION

If more than one screen,
show locations of each on sketch.