

SUNFLOWER  
 Q 48  
 6/30/80

MISSISSIPPI  
 BOARD OF WATER COMMISSIONERS  
 416 North State Street  
 Jackson, Mississippi 39201

CODED

WATER WELL DRILLERS LOG

6/30 1980 DYER WELL & IRR. SUNFLOWER  
 date well completed firm name county well located

LANDOWNER: TRANS FISHERIES  
 R.R. 1 - Box 51  
 YAZOO CITY, MISS. 39194  
 (mailing address)

description of formations encountered	from	to
CLAY	0	23
FINE SAND	23	43
SAND & GRAVEL	43	93

WELL LOCATION:  
 sec. 13 T. 18 N. R. 4 E. (W)  
 S  
 1 miles NW of MARKHAM  
 (distance) (direction) (nearest town)

WELL PURPOSE:  
 (home, irrigation, municipal, industrial)

WELL COMPLETION DATA:

(1) diameter (inches) 16"  
 (2) total depth (feet) 93  
 (3) static water level (feet) 22 below above top of ground.  
 (4) casing 16" 53 (material) (depth)  
 16 If telescope see back. (size)  
 (5) screen 40 53 (length) (depth to top)  
 16 STEEL (size) (material)  
 (6) pump 60 2800 (HP) (yield gpm)  
 DIESEL (type power)  
 (7) electric log NO (yes or no)

CODED

DEPT. OF NATURAL RESOURCES  
 BUREAU OF LAND & WATER RESOURCES

OCT 14 1980


RECEIVED

(organization running log)  
 (8) how well bottom plugged STEEL PLATE

DRILLERS REMARKS:

If well telescopes please sketch and show depths.

GROUND LEVEL

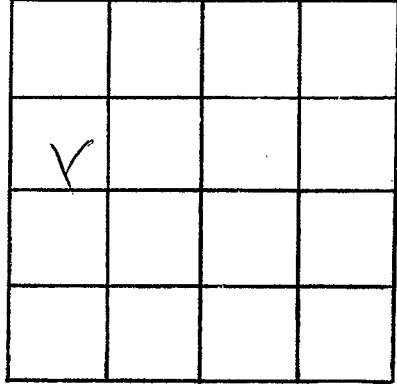

SECTION 13

Please indicate well location X.

ADDITIONAL INFORMATION

If more than one screen,  
show locations of each on sketch.