

MISSISSIPPI DEPARTMENT OF NATURAL RESOURCES

Bureau of Land and Water Resources

Southport Mall

P.O. Box 10631

Jackson, Mississippi 39209

WATER WELL DRILLERS LOG

CODED

SUNFLOWER
Q 50
4/7/80

4/7 1980 OYER WELL # 1 RR SUNFLOWER
 date well completed firm name county well located

LANDOWNER:
 SEYMOUR JOHNSON

INDIANOLA 38751
 (mailing address)

WELL LOCATION:
 sec. 31 T. 18 N. R. 4 E S
 4 1/2 miles S of INDIANOLA
 (distance) (direction) (nearest town)

WELL PURPOSE:
 (home, irrigation, municipal, industrial)

WELL COMPLETION DATA:

(1) diameter (inches) 12"
 (2) total depth (feet) 103
 (3) static water level (feet) 20 below top of ground.
 (4) casing STEEL, 63 (material), (depth),
 12 (size) if telescope see back.
 (5) screen 40 (length), 63 (depth to top),
 12" (size), STEEL (material)
 (6) pump 40 (HP), 1800 (yield gpm)
 DIESEL (type power)
 (7) electric log X10 (yes or no)
 (organization running log)
 (8) how well bottom plugged STEEL PLATE

description of formations encountered	from	to
CLAY	0	28
FINE SAND	28	38
SAND	38	45
SAND & GRAVEL	45	103

CODED

DEPT. OF NATURAL RESOURCES
 BUREAU OF LAND & WATER RESOURCES


OCT 14 1980

RECEIVED

DRILLERS REMARKS:

If well telescopes please sketch and show depths.

GROUND LEVEL

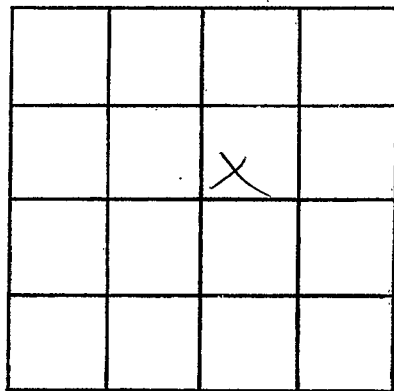

SECTION 31

Please indicate well location X.

ADDITIONAL INFORMATION

If more than one screen, show locations of each on sketch.