

Bureau of Land and Water Resources

Southport Mall

P.O. Box 10631

Jackson, Mississippi 39204 **CODED** ⁴²

WATER WELL DRILLERS LOG

Sunflower
Q 54
1-13-81

1/13
date well completed

1981

Dyer
firm name

Sum
county well located

LANDOWNER:

BILLY SIMMONS

description of formations encountered

from to

Moorehead, MS.
(mailing address)

<u>san</u>	<u>23</u>	<u>33</u>
<u>sand clay</u>	<u>33</u>	<u>43</u>
<u>san</u>	<u>43</u>	<u>53</u>
<u>san</u>	<u>63</u>	<u>73</u>
<u>sand + granite</u>	<u>73</u>	<u>83</u>
<u>granite</u>	<u>83</u>	<u>93</u>
<u>granite</u>	<u>93</u>	<u>103</u>
<u>granite</u>	<u>103</u>	<u>113</u>

WELL LOCATION:

sec 1 T 180 R 4
S 5 miles SE of Indochade
(distance) (direction) (nearest town)

WELL PURPOSE:
(home, irrigation, municipal, industrial)

WELL COMPLETION DATA:

(1) diameter (inches) 16"

(2) total depth (feet) 113'

(3) static water level (feet) 20' below top of ground.

(4) casing Steel 113'
(material) (depth)

16" If telescope see back.
(size)

(5) screen 40' 73'
(length) (depth to top)

16" Steel
(size) (material)

(6) pump 60 3000
(HP) (yield gpm)

Diesel
(type power)

(7) electric log (yes or no)


(organization running log)

(8) how well bottom plugged flat

DRILLERS REMARKS:

CODED



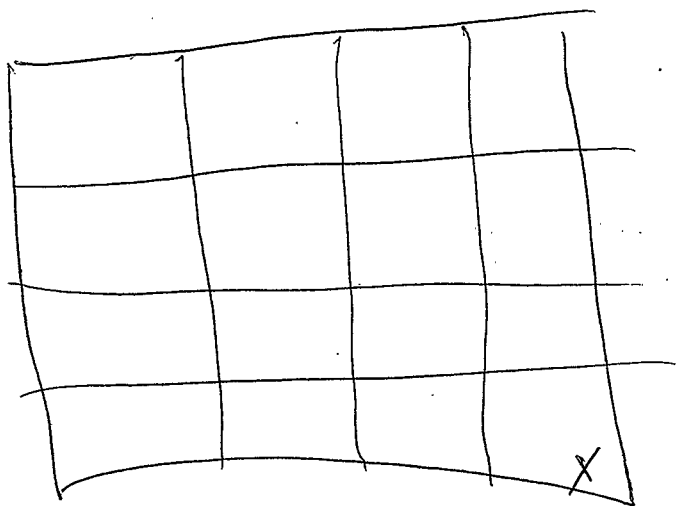

Sec 1