

MISSISSIPPI DEPARTMENT OF NATURAL RESOURCES
 Bureau of Land and Water Resources
 Southport Mall
 P.O. Box 10631
 Jackson, Mississippi 39209
WATER WELL DRILLERS LOG

Sunflower
Q 55
1-10-81

0002
CODED

1/10 19 81 Dyer Sum.
 date well completed firm name county well located

LANDOWNER:
BILLY SIMMONS
Moorehead, MS.
 (mailing address)


description of formations encountered	from	to
	<u>Clay</u>	<u>0</u>
<u>Fine sand</u>		
<u>Sand</u>		
<u>Sand & gravel</u>	<u>55</u>	<u>86</u>

WELL LOCATION:
 sec. L T 18 N R. 4 E
5 miles 58 of Indianola
 (distance) (direction) (nearest town)

WELL PURPOSE:
 (home irrigation municipal, industrial)

CODED

- WELL COMPLETION DATA:
- (1) diameter (inches) 10"
 - (2) total depth (feet) 86'
 - (3) static water level (feet) 20' below top of ground.
 - (4) casing Steel, 86'
 (material) (depth)
10" If telescopic see back.
 (size)
 - (5) screen 40', 46'
 (length) (depth to top)
10" Steel
 (size) (material)
 - (6) pump 25 1200
 (HP) (yield-gpm)
Electric
 (type power)
 - (7) electric log _____
 (yes or no)
 (organization running log)
 - (8) how well bottom plugged None

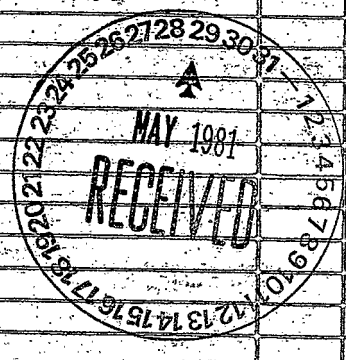

DRILLERS REMARKS:

A hand-drawn grid consisting of 4 columns and 4 rows. The grid is slightly irregular in shape. An 'X' is drawn in the top-right cell of the grid.

			X

Sec. 12