

MISSISSIPPI DEPARTMENT OF NATURAL RESOURCES
 Bureau of Land and Water Resources
 Southport Mall
 P.O. Box 10631
 Jackson, Mississippi 39209
WATER WELL DRILLERS LOG **CODED.**

Sunflower
 Q 56
 1-9-81

date well completed: 19 81 / 9 / 1 *Dyer* *Sum.*
 from name county well located

LANDOWNER:
BILLY SIMMONS
Moorestead, MS.
 (mailing address)


WELL LOCATION:
 sec. 12 T-18 (N) R-4 (E)
5 miles SE of Anders
 (distance) (direction) (nearest town)

WELL PURPOSE:
 (home, irrigation, municipal, industrial)

- WELL COMPLETION DATA:
- (1) diameter (inches) 16"
 - (2) total depth (feet) 113'
 - (3) static water level (feet) 20' below above top of ground.
 - (4) casing Steel 113'
 (material) (depth)
16" if telescopes go back.
 (size)
 - (5) screen 40' 73'
 (length) (depth to top)
16" Steel
 (size) (material)
 - (6) pump 60 3000
 (HP) (yield gpm)
Direct
 (type power)
 - (7) electric log _____
 (yes or no)
 (organization running log)
 - (8) how well bottom plugged plate

description of formations encountered	from	to
Soil	0	5'
Soil	33	43'
Soil	43	58'
soil & gravel	58	63'
soil & gravel	63	73'
gravel	73	83'
gravel	83	93'
gravel	93	103'
gravel	103	113'

CODED.

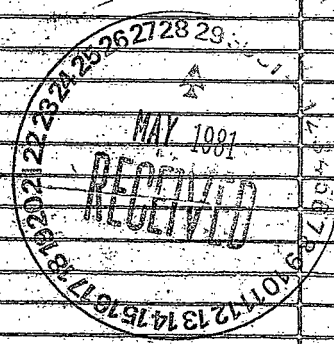

DRILLERS REMARKS:

		x		

Sec 12