

Sunflower
 57
 3-5-81

3/5 19 81 Dyer Jen.
 date well completed firm name county well located

LANDOWNER:
JACK CATLETTE
Irweness, MS.
 (mailing address)


description of formations encountered	from	to
<u>Clay</u>	<u>0</u>	<u>38</u>
<u>fine sand</u>	<u>38</u>	<u>48</u>
<u>small</u>	<u>48</u>	<u>58</u>
<u>sand + gravel</u>	<u>58</u>	<u>103</u>

WELL LOCATION:
 sec. 25 T. 18 N. R. 4 E
2 miles NE of Irweness
 (distance) (direction) (nearest town)

WELL PURPOSE:
 (home, irrigation, municipal, industrial)

- WELL COMPLETION DATA:
- diameter (inches) 16 1/2"
 - total depth (feet) 103'
 - static water level (feet) 21' below above top of ground.
 - casing Steel, 103'
 (material) (depth)
16" if telescope see back.
 (size)
 - screen 40', 63'
 (length) (depth to top)
16", Steel
 (size) (material)
 - pump 60, 3000
 (HP) (yield gpm)
electric
 (type power)
 - electric log yes or no
 (organization running log)
 - how well bottom plugged plate

CODED

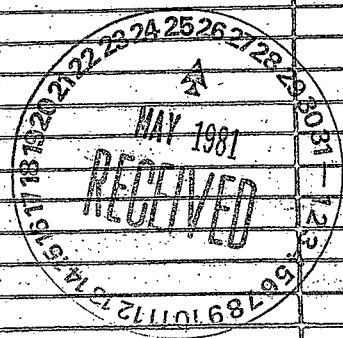

DRILLERS REMARKS:

	X		

sec 25