

Bureau of Land and Water Resources

Southport Mall

P.O. Box 10631

Jackson, Mississippi 39209

WATER WELL DRILLERS LOG CODE

Sunflower

Q58

3-5-81

012

3/5 19 81 Dyer J. Lee
 date well completed first name county well located

LANDOWNER:

JACK CATLETTE

Inverness, MS.

(mailing address)

Description of formations encountered from

Clay	8	2
Sand	21	4
Sand + Gravel	48	9

WELL LOCATION:

sec 25 T18 N R 4 E S W

2 miles NE of Inverness
 (distance) (direction) (nearest town)

CODED

WELL PURPOSE:
 (home, irrigation, municipal, industrial)

WELL COMPLETION DATA:

(1) diameter (inches) 12"

(2) total depth (feet) 93'

(3) static water level (feet) 20' below top of ground.

(4) casing steel 93'
 (material) (depth)

12" If telescope see back.
 (size)

(5) screen 40' 63'
 (length) (depth to top)

12" steel
 (size) (material)


(6) pump 30 1200
 (HP) (yield gpm)

electric
 (type power)

(7) electric log (yes or no)

(organization running log)

(8) how well bottom plugged plate

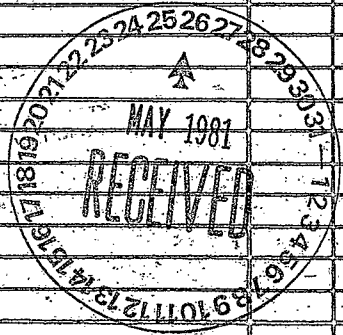

DRILLERS REMARKS:

x			

See 25
