

MISSISSIPPI DEPARTMENT OF LAND AND WATER RESOURCES  
 Bureau of Land and Water Resources  
 Southport (Mail)  
 P.O. Box 10631  
 Jackson, Mississippi 39209  
**WATER WELL DRILLERS LOG**

**CODED**

Sanflower  
Q59  
5-20-81

date well completed 5-20-81 by Dr. J. W. Fisher firm name Dr. J. W. Fisher county well located Sanflower

LANDOWNER Paul Smith  
Moorehead, Mo.  
 (mailing address)

| description of formations encountered | from      | to         |
|---------------------------------------|-----------|------------|
| <u>Clay</u>                           | <u>0</u>  | <u>68</u>  |
| <u>fine sand</u>                      | <u>35</u> | <u>68</u>  |
| <u>sand &amp; gravel</u>              | <u>68</u> | <u>113</u> |

WELL LOCATION:  
 sec 13 15 R 4 E  
4 miles S of Moorehead  
 (distance) (direction) (nearest town)

WELL PURPOSE:  
 (home irrigation, municipal, industrial)

WELL COMPLETION DATA:

(1) diameter (inches) 16"

(2) total depth (feet) 113'

(3) static water level (feet) 22' below above top of ground

(4) casing Steel 113'  
 (material) (depth)

16" If telescope soo back.  
 (size)

(5) screen 40' 73'  
 (length) (depth to top)

16" Steel  
 (size) (material)

(6) pump 60 3000  
 (HP) (yield gpm)


Diaseal  
 (type power)

(7) electric log (yes or no)


(organization running log)

(8) how well bottom plugged plate

**CODED**

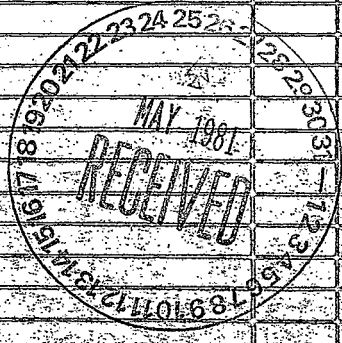

DRILLERS REMARKS:

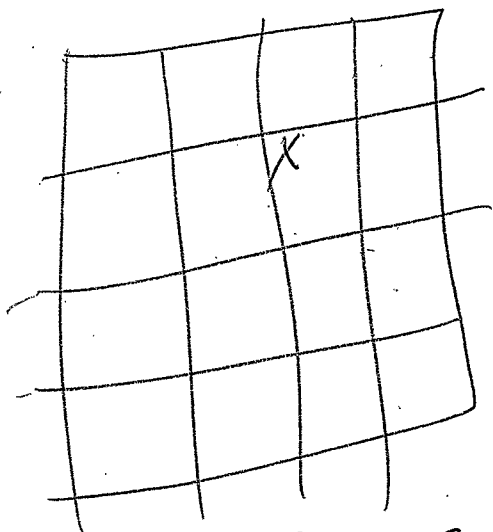

sec 13