

MISSISSIPPI DEPARTMENT OF NATURAL RESOURCES

Bureau of Land and Water Resources

Southport Mall

P.O. Box 10631

Jackson, Mississippi 39209

WATER WELL DRILLERS LOG

CODED

Sun Flower  
Q60  
2-24-81

Feb 24, 19 81 Larry's Well & Pump Sun Flower  
 date well completed firm name county well located

LANDOWNER: Cobb Fish  
Belzoni, MS  
 (mailing address)

description of formations encountered	from	to
<u>clay</u>	<u>0</u>	<u>25</u>
<u>fine sand</u>	<u>25</u>	<u>35</u>
<u>med sand</u>	<u>35</u>	<u>50</u>
<u>coarse sand &amp; gravel</u>	<u>50</u>	<u>105</u>

WELL LOCATION:  
 sec. 27-17 N R 4  
3 miles N of Belzoni  
 (distance) (direction) (nearest town)

WELL PURPOSE: Fish Pond  
 (home, irrigation, municipal, industrial)

WELL COMPLETION DATA:

(1) diameter (inches) 16"

(2) total depth (feet) 105'

(3) static water level (feet) 19' below above top of ground.

(4) casing Steel, 65',  
 (material) (depth)  
 (size) if telescope see back.

(5) screen 40', 65'  
 (length) (depth to top)  
16", Steel  
 (size) (material)

(6) pump \_\_\_\_\_ (HP) \_\_\_\_\_ (yield gpm)  
 (type power)

(7) electric log No  
 (yes or no)  
 (organization running log)

(8) how well bottom plugged Steel Plate

CODED

MISSISSIPPI DEPARTMENT OF NATURAL RESOURCES  
 BUREAU OF LAND & WATER RESOURCES


JUN 5 - 1981

RECEIVED

DRILLERS REMARKS: \_\_\_\_\_

If well telescopes please sketch and show depths.

GROUND LEVEL

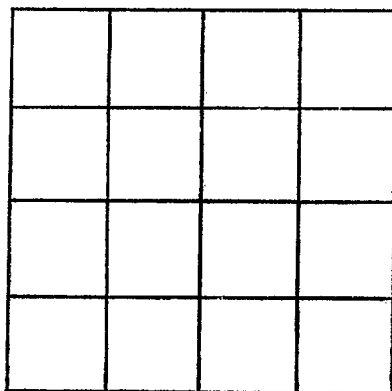

SECTION \_\_\_\_\_

Please indicate well location X.

ADDITIONAL INFORMATION

If more than one screen,  
show locations of each on sketch.