

MISSISSIPPI DEPARTMENT OF NATURAL RESOURCES

Bureau of Land and Water Resources

Southport Mall

P.O. Box 10631

Jackson, Mississippi 39209


WATER WELL DRILLERS LOG

CODED

sunflower
Q61
4-8-81


April 08 1981 Larry's Well's Pump sunflower
 date well completed firm name county well located

LANDOWNER: <u>Charles McCauley</u>	description of formations encountered		from	to
<u>Isola, Mo</u> (mailing address)	<u>Clay</u>		<u>0</u>	<u>35</u>
	<u>Fine sand</u>		<u>35</u>	<u>60</u>
	<u>Med & coarse sand</u>		<u>60</u>	<u>100</u>
WELL LOCATION: sec. <u>35</u> T. <u>17</u> N R. <u>4</u> E (distance) <u>3</u> miles (direction) <u>N</u> of <u>Isola</u> (nearest town)				
WELL PURPOSE: (home, irrigation, municipal, industrial)				
WELL COMPLETION DATA:				
(1) diameter (inches) <u>8"</u>	CODED			
(2) total depth (feet) <u>100'</u>				
(3) static water level (feet) <u>19</u> below above top of ground.				
(4) casing <u>Plastic</u> , <u>60'</u> (material) (depth)				
<u> </u> if telescope see back. (size)				
(5) screen <u>40'</u> , <u>60'</u> (length) (depth to top)				
<u>8"</u> , <u>Plastic</u> (size) (material)				
(6) pump <u>10</u> <u>700</u> (HP) (yield gpm)				
<u>Elec.</u> (type power)				
(7) electric log <u>NO</u> (yes or no)				
<u> </u> (organization running log)				
(8) how well bottom plugged <u>Pvc cap</u>				
DRILLERS REMARKS:				

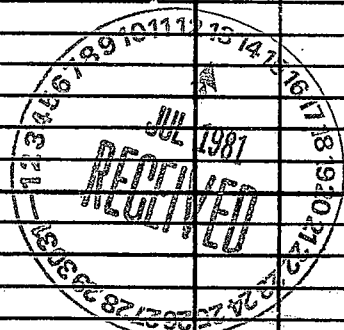

If well telescopes please
sketch and show depths.

GROUND LEVEL

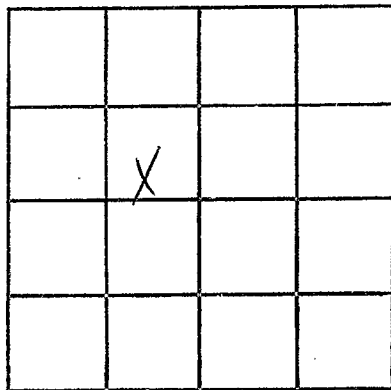

SECTION 35

Please indicate well location X.

ADDITIONAL INFORMATION

If more than one screen,
show locations of each on sketch.