

MISSISSIPPI DEPARTMENT OF NATURAL RESOURCES

Bureau of Land and Water Resources

Southport Mall

P.O. Box 10631

Jackson, Mississippi 39209

WATER WELL DRILLERS' LOG

**CODED**

Sunflower  
Q 62  
8-11-81

8-11-1981 date well completed      Piper Well firm name      Sunflower county well located

LANDOWNER: Holly Ridge  
Box 95  
Indianola, Ms  
(mailing address)

WELL LOCATION:  
sec. 31 T. 18 (N) R. 4 E. (W)  
3 miles (distance) W (direction) of Indianola (nearest town)


WELL PURPOSE:  
(home, irrigation, municipal, industrial)

- WELL COMPLETION DATA:
- (1) diameter (inches) 16
  - (2) total depth (feet) 108'
  - (3) static water level (feet) 22' below above top of ground.
  - (4) casing Steel (material) (depth)  
16 (size) if telescope see back.
  - (5) screen 40 68' (length) (depth to top)  
16 (size) Steel (material)
  - (6) pump 1/2 3000 (HP) (yield gpm)  
Diesel (type power)
  - (7) electric log No (yes or no)

(organization running log)

(8) how well bottom plugged Plate

description of formations encountered	from	to
<u>Clay</u>	<u>13</u>	<u>23</u>
<u>sil</u>	<u>23</u>	<u>33</u>
<u>Clay-sand</u>	<u>33</u>	<u>43</u>
<u>Sand</u>	<u>43</u>	<u>53</u>
<u>gravel</u>	<u>53</u>	<u>63</u>
<u>gravel</u>	<u>63</u>	<u>73</u>
<u>sand-gravel</u>	<u>73</u>	<u>83</u>
<u>sand-gravel</u>	<u>83</u>	<u>93</u>
<u>gravel</u>	<u>93</u>	<u>103</u>
<u>gravel</u>	<u>103</u>	<u>108</u>

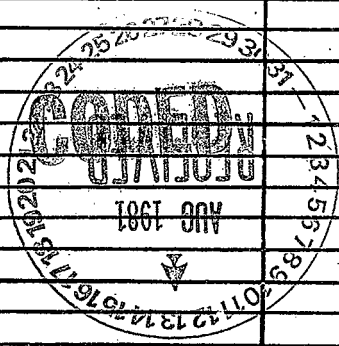

DRILLERS REMARKS:

If well telescopes please sketch and show depths.

GROUND LEVEL

			X

SECTION 31

Please indicate well location X.

ADDITIONAL INFORMATION

If more than one screen, show locations of each on sketch.