

MISSISSIPPI DEPARTMENT OF NATURAL RESOURCES

Bureau of Land and Water Resources

Southport Mall

P.O. Box 10631

Jackson, Mississippi 39209 **CODED**

WATER WELL DRILLERS LOG

**SUNFLOWER**  
**Q 65**  
**10-28-81**

10-28 1981  
 date well completed

Dice Well & Irrigation  
 firm name

Sunflower  
 county well located

LANDOWNER: Seymour Johnson

description of formations encountered

from

to

P.O. Box 7

Indianola, Miss.  
 (mailing address)

Clay 0 15  
fine sand 18 30  
sand 30 45  
sand & gravel 45 103

WELL LOCATION:

sec. 9 T 18 N R. 4 E  
2 miles SE of Indianola  
 (distance) (direction) (nearest town)

WELL PURPOSE: Irrigation  
 (home, irrigation, municipal, industrial)

WELL COMPLETION DATA:


- (1) diameter (inches) 16"
- (2) total depth (feet) 103'
- (3) static water level (feet) 21 below top of ground.
- (4) casing Steel, 63  
 (material) (depth)  
16" if telescope see back.  
 (size)
- (5) screen 40', 63  
 (length) (depth to top)  
16", Mild Steel  
 (size) (material)
- (6) pump 40 2000  
 (HP) (yield gpm)  
Diesel  
 (type power)
- (7) electric log No  
 (yes or no)  
NONE  
 (organization running log)
- (8) how well bottom plugged Plate

DRILLERS REMARKS:

DEPT. OF NATURAL RESOURCES  
 BUREAU OF LAND & WATER RESOURCES  
 NOV 6 - 1981  
**RECEIVED**

If well telescopes please sketch and show depths.

GROUND LEVEL

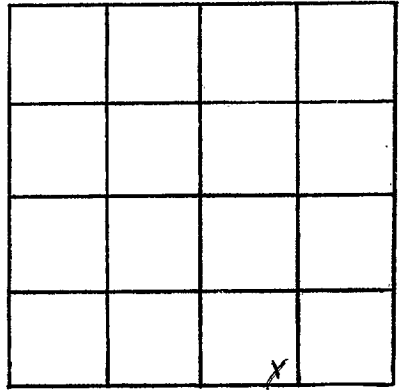

SECTION 9

Please indicate well location X.

ADDITIONAL INFORMATION

If more than one screen,  
show locations of each on sketch.