

SUNFLOWER  
 067  
 11/4/81

MISSISSIPPI DEPARTMENT OF NATURAL RESOURCES  
 Bureau of Land and Water Resources  
 Southport Mall  
 P.O. Box 10631  
 Jackson, Mississippi 39209  
**WATER WELL DRILLERS LOG**

**CODED**

11-4 1981 Dyer Well + Irr. Service Sunflower  
 date well completed firm name county well located

LANDOWNER: Rodgers Brasher  
Indianola, Miss.  
 (mailing address)

WELL LOCATION:  
 sec. 14 T. 18 N. R. 4 E  
1 miles S of Band  
 (distance) (direction) (nearest town)

WELL PURPOSE: Irrigation  
 (home, irrigation, municipal, industrial)

WELL COMPLETION DATA:

- (1) diameter (inches) 16"
- (2) total depth (feet) 133'
- (3) static water level (feet) 20' below top of ground.
- (4) casing Steel, 93,  
 (material) (depth)  
12" If telescope see back.  
 (size)
- (5) screen 40', 93  
 (length) (depth to top)  
16", Steel  
 (size) (material)
- (6) pump 100 1500  
 (HP) (yield gpm)  
Diesel  
 (type power)
- (7) electric log NO  
 (yes or no)  
None  
 (organization running log)
- (8) how well bottom plugged Plate

description of formations encountered	from	to
Clay	0	18
Gravel sand	18	37
Sand	37	79
Fine sand	55	76
Sand & gravel	76	85
Fine sand	85	90
Sand & gravel	90	133

**CODED**

DEPT. OF NATURAL RESOURCES  
 BUREAU OF LAND & WATER RESOURCES


DEC 10 1981

**RECEIVED**

DRILLERS REMARKS:

If well telescopes please sketch and show depths.

GROUND LEVEL

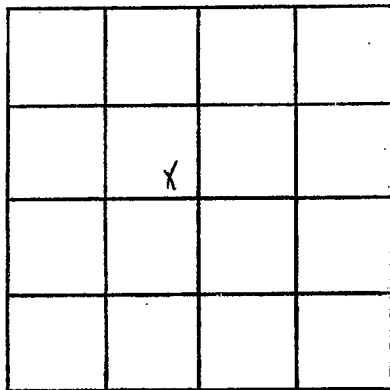

SECTION 14

Please indicate well location X.

ADDITIONAL INFORMATION

If more than one screen,  
show locations of each on sketch.