

MISSISSIPPI DEPARTMENT OF NATURAL RESOURCES

Bureau of Land and Water Resources

Southport Mall

P.O. Box 10631

CODED

Jackson, Mississippi 39209

WATER WELL DRILLERS LOG

Sumflow
RQ 69
08/30/82

date well completed 19

Open well
 firm name

Sumflow
 county well located

LANDOWNER: W. D. Eminors

description of formations encountered

from

to

Burd Ms.
 (mailing address)

Clay	0	44
Fine Sand	44	72
Sand + gravel	72	113

WELL LOCATION:

sec. 2 T. 18 N. R. 4 E
 (distance) miles W of Burd
 (direction) (nearest town)

WELL PURPOSE:
 (home, irrigation, municipal, industrial)

WELL COMPLETION DATA:

- (1) diameter (inches) 10" PVC
- (2) total depth (feet) 113
- (3) static water level (feet) 18 below above top of ground.
- (4) casing plastic, 73
 (material) (depth)
- 10 if telescope see back.
 (size)
- (5) screen 40, 113
 (length) (depth to top)
- 10, PVC
 (size) (material)
- (6) pump 20, 1,000
 (HP) (yield gpm)
- electric
 (type power)
- (7) electric log no
 (yes or no)

(organization running log)

(8) how well bottom plugged Plate


DRILLERS REMARKS:

DEPT. OF NATURAL RESOURCES
 BUREAU OF LAND & WATER RESOURCES

SEP 30 1982
 RECEIVED

If well telescopes please sketch and show depths.

GROUND LEVEL

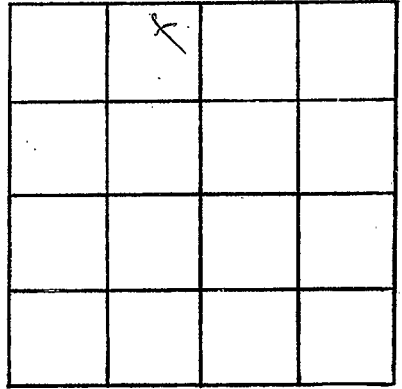

SECTION 2

Please indicate well location X.

ADDITIONAL INFORMATION

If more than one screen,
show locations of each on sketch.