

MISSISSIPPI DEPARTMENT OF NATURAL RESOURCES

Bureau of Land and Water Resources

Southport Mall

P.O. Box 10631

Jackson, Mississippi 39209

WATER WELL DRILLERS LOG

CODED

Sunflower
 Q 70
 4/4/82

John Patton Chesin
 Drilling Equipment, Inc.

4/4/82

date well completed

19

firm name

Sunflower

county well located

LANDOWNER: A. D. Simmons

description of formations encountered

from

to

Clay	0	26'
Fine Sand	26'	48'
Coarse sand	48'	55'
Coarse sand/small gravel	55'	60'
Coarse sand/large gravel	60'	75'
Blue Clay	75'	81'
Coarse sand/small gravel & Clay Mix	81'	90'
Coarse sand/large gravel	90'	103'

(mailing address)

WELL LOCATION:

sec. 4 T 18 N S R 4 E W
 1 1/2 miles SE of Indianola
 (distance) (direction) (nearest town)

WELL PURPOSE: irrigation
 (home, irrigation, municipal, industrial)

WELL COMPLETION DATA:

- (1) diameter (inches) 12"
- (2) total depth (feet) 103'
- (3) static water level (feet) 28' below top of ground.
- (4) casing steel 63' (material) (depth)
- (size) if telescope see back.
- (5) screen 40' 63' (length) (depth to top)
- 12" steel (size) (material)
- (6) pump 100 1300 (HP) (yield gpm)
- Direct* (type power)
- (7) electric log (yes or no)

(organization running log)

(8) how well bottom plugged steel plate

DEPT. OF NATURAL RESOURCES
 BUREAU OF LAND & WATER RESOURCES


MAY - 3 1982

RECEIVED

DRILLERS REMARKS:

If well telescopes please sketch and show depths.

GROUND LEVEL

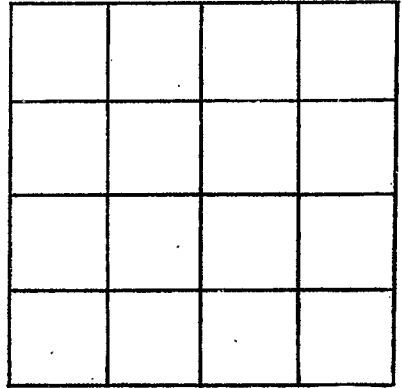

SECTION _____

Please indicate well location X.

ADDITIONAL INFORMATION

If more than one screen, show locations of each on sketch.