

SUNFLOWER

MISSISSIPPI DEPARTMENT OF NATURAL RESOURCES

Bureau of Land and Water Resources

Southport Mall

P.O. Box 10631

Jackson, Mississippi 39209

WATER WELL DRILLERS LOG

CODED

~~August~~
 Q 71
 5/18/82

5/18/1982 date well completed
 South Delta Irrigator firm name
 Sunflower county well located

LANDOWNER:
 J. B. Reed
 Inverness, MS.
 (mailing address)

description of formations encountered	from	to
clay	0	20
fine sand	20	40
coarse sand	40	60
medium sand		
coarse sand & gravel	60	113

WELL LOCATION:
 sec. 15 T-18 N R-4 E
 S W
 4 miles N of Inverness
 (distance) (direction) (nearest town)

WELL PURPOSE:
 (home, irrigation, municipal, industrial)

WELL COMPLETION DATA:

(1) diameter (inches) 16"

(2) total depth (feet) 113'

(3) static water level (feet) 22' below top of ground.

(4) casing steel 73'
 (material) (depth)
 16" (size) if telescope see back.

(5) screen 40 73
 (length) (depth to top)
 16" steel
 (size) (material)

(6) pump 60 1200
 (HP) (yield gpm)
 Diesel
 (type power)

(7) electric log no
 (yes or no)

(organization running log)

(8) how well bottom plugged plate

DRILLERS REMARKS:


DEPT. OF NATURAL RESOURCES
 BUREAU OF LAND & WATER RESOURCES

MAY 25 1982

RECEIVED

If well telescopes please sketch and show depths.

GROUND LEVEL

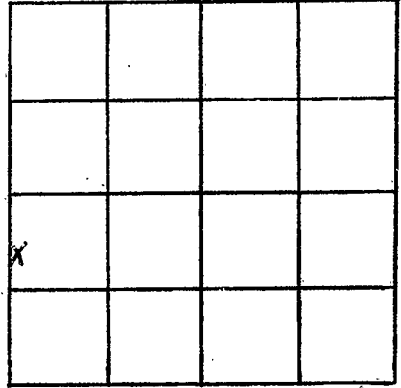

SECTION 15

Please indicate well location X.

ADDITIONAL INFORMATION

If more than one screen,
show locations of each on sketch.