

Sunflower

Q 72

CL-2103

4/26/82

MISSISSIPPI BOARD OF WATER COMMISSIONERS  
416 North State Street  
Jackson, Mississippi 39201

CODED

WATER WELL DRILLERS LOG

4-26 1982 LAYNE CENTRAL CO. SUNFLOWER  
date well completed firm name county well located

LANDOWNER:

DUNCAN FARMS

WELL #1

INVERNESS, MS

(mailing address)

WELL LOCATION: #1 of 2

sec. 26 T. 18 N. R. 4 W  
2 miles NE of INVERNESS  
(distance) (direction) (nearest town)

description of formations encountered	from	to
clay	0	14
fine sand	14	42
clay	42	52
coarse sand	52	62
coarse sand	62	72
coarse sand & gravel	72	82
coarse sand & gravel	82	92
coarse sand & gravel	92	102
coarse sand & gravel	102	125

WELL PURPOSE:

(home irrigation, municipal, industrial)

WELL COMPLETION DATA:

- (1) diameter (inches) 32"
- (2) total depth (feet) 125'
- (3) static water level (feet) 22' below top of ground.
- (4) casing steel 75' (material), (depth)  
16" (size) if telescope see back.
- (5) screen 50' 75' (length), (depth to top)  
16" (size) st. steel (material)
- (6) pump 60 2500 (HP), (yield gpm)  
diesel (type power)
- (7) electric log no (yes or no)  
(organization running log) st. plate
- (8) how well bottom plugged

DEPT. OF NATURAL RESOURCES  
BUREAU OF LAND & WATER RESOURCES


JUN 24 1982

RECEIVED

DRILLERS REMARKS:

If well telescopes please sketch and show depths.

GROUND LEVEL

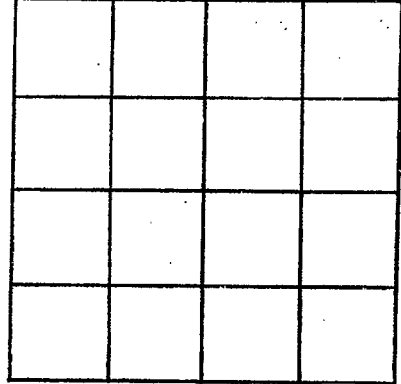

SECTION \_\_\_\_\_

Please indicate well location X.

ADDITIONAL INFORMATION

A series of horizontal lines for recording additional information, starting below the 'ADDITIONAL INFORMATION' header and extending to the bottom of the page.

more than one screen,  
w locations of each on sketch.