

*Sunflower*  
 Q 73  
 CL-2103  
 4/30/82

MISSISSIPPI  
 BOARD OF WATER COMMISSIONERS  
 416 North State Street  
 Jackson, Mississippi 39201

CODED

WATER WELL DRILLERS LOG

4-30 1982 date well completed Layne Central Co. firm name SUNFLOWER county well located

LANDOWNER:  
 DUNCAN FARMS *WELL # 2*  
 INVERNESS, MS  
 (mailing address)  
 WELL LOCATION: # 2 of 2  
 sec. 26 T. 18 N R. 4 W  
 2 miles NE of Inverness  
 (distance) (direction) (nearest town)

description of fomations encountered	from	to
clay	0	14
fine sand	14	22
fine sand	22	60
coarse sand	60	62
coarse sand & gravel	62	82
coarse sand & gravel	82	92
coarse sand & gravel	92	102
coarse sand & gravel	102	115

WELL PURPOSE:  
 (home irrigation, municipal, industrial)

WELL COMPLETION DATA:  
 (1) diameter (inches) 32"  
 (2) total depth (feet) 115'  
 (3) static water level (feet) 20' below top of ground.  
 (4) casing steel 65' (material), (depth), 16" (size) If telescope see back.  
 (5) screen 50' 65' (length), (depth to top) 16" st. steel (size), (material)  
 (6) pump 60 2500 (HP), (yield gpm) electric (type power)  
 (7) electric log no (yes or no)  
 (organization running log) st. plate  
 (8) how well bottom plugged

DEPT. OF NATURAL RESOURCES  
 BUREAU OF LAND & WATER RESOURCES


JUN 24 1982

RECEIVED

DRILLERS REMARKS:

If well telescopes please sketch and show depths.

GROUND LEVEL

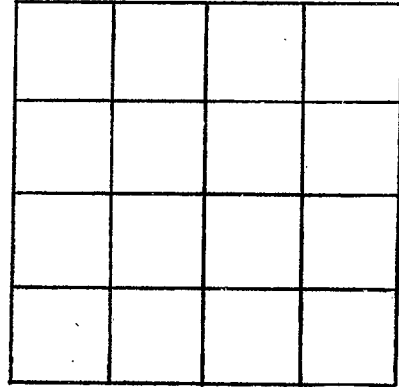

SECTION \_\_\_\_\_

Please indicate well location X.

ADDITIONAL INFORMATION

If more than one screen,  
show locations of each on sketch.