

## MISSISSIPPI DEPARTMENT OF NATURAL RESOURCES

Bureau of Land and Water Resources

Southport Mall

P.O. Box 10631

Jackson, Mississippi 39209

## WATER WELL DRILLERS LOG

CODED

Dec 16 1981  
date well completedDyer Wells Irrigation  
firm nameSunflower  
county well located

LANDOWNER:

~~Steve Sharden~~

Seymour Johnson

Indianola,  
Miss

(mailing address)

WELL LOCATION:

sec. 9 T. 18 N. R. 4 E.

2 miles SE of Indianola  
(distance) (direction) (nearest town)

WELL PURPOSE:

Irrigation

(home, irrigation, municipal, industrial)

description of formations  
encountered

from

to

Clay + Sand

0

13

fine sand

13

23

fine sand

23

33

Coarse Sand

33

43

Coarse Sand

43

53

Sand &amp; Gravel

53

63

" "

63

73

" "

73

83

" "

83

93

" "

93

103

WELL COMPLETION DATA:

(1) diameter (inches) 12"

(2) total depth (feet) 103

(3) static water level (feet) 18' below  
top of ground.(4) casing Steel 63  
(material) (depth)12" if telescope see back.  
(size)(5) screen 40' 63  
(length) (depth to top)12" Mild Steel  
(size) (material)(6) pump 40 2000  
(HP) (yield gpm)diesel  
(type power)(7) electric log No  
(yes or no)

(organization running log)

(8) how well bottom plugged Plute

DRILLERS REMARKS:


DEPT. OF NATURAL RESOURCES  
BUREAU OF LAND & WATER RESOURCES

JUN 30 1982

RECEIVED

If well telescopes please  
sketch and show depths.

GROUND LEVEL

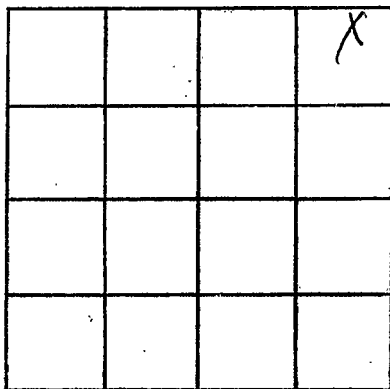

SECTION 9

Please indicate well location X.

ADDITIONAL INFORMATION

If more than one screen,  
show locations of each on sketch.