

Sunflower
Q 75
5-18-82

MISSISSIPPI DEPARTMENT OF NATURAL RESOURCES
 Bureau of Land and Water Resources
 Southport Mall
 P.O. Box 10631
 Jackson, Mississippi 39209
WATER WELL DRILLERS LOG

CODED

May 18 1982 South Delta Sunflower
 date well completed firm name county well located


| LANDOWNER: | description of formations encountered | from | to |
|--|---------------------------------------|-----------|------------|
| <u>J. B. Reed</u> <u>Inverness, MS</u> (mailing address) | | | |
| WELL LOCATION: sec. <u>15</u> T- <u>18</u> (N) S R. <u>4</u> E (W) <u>4</u> miles <u>N</u> of <u>Inverness</u> (distance) (direction) (nearest town) | <u>fine sand</u> | <u>20</u> | <u>40</u> |
| WELL PURPOSE: (home, irrigation, municipal, industrial) | <u>medium sand</u> | <u>40</u> | <u>60</u> |
| WELL COMPLETION DATA: | <u>coarse sand w/ gravel</u> | <u>60</u> | <u>113</u> |
| (1) diameter (inches) <u>16"</u> | | | |
| (2) total depth (feet) <u>113'</u> | | | |
| (3) static water level (feet) <u>22'</u> below above top of ground. | | | |
| (4) casing <u>Steel</u> , <u>73'</u> (material) (depth) <u>16"</u> if telescope see back. (size) | | | |
| (5) screen <u>40'</u> <u>73'</u> (length) (depth to top) <u>16"</u> <u>steel</u> (size) (material) | | | |
| (6) pump <u>60</u> <u>1700</u> (HP) (yield gpm) <u>Diesel</u> (type power) | | | |
| (7) electric log <u>NO</u> (yes or no) (organization running log) | | | |
| (8) how well bottom plugged <u>plate</u> | | | |
| DRILLERS REMARKS: | | | |

DEPT. OF NATURAL RESOURCES
 BUREAU OF LAND & WATER RESOURCES

SEP - 8 1982
RECEIVED

If well telescopes please sketch and show depths.

GROUND LEVEL

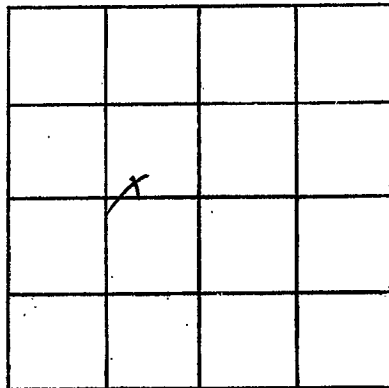

SECTION 15

Please indicate well location X.

ADDITIONAL INFORMATION

If more than one screen, show locations of each on sketch.