

MISSISSIPPI DEPARTMENT OF NATURAL RESOURCES

Bureau of Land and Water Resources

Southport Mall

P.O. Box 10631

Jackson, Mississippi 39209

WATER WELL DRILLERS LOG

CODED

<i>Sunflower</i>
Q 76
416182

4-6-82 date well completed *Oger Well* firm name *Sunflower* county well located


LANDOWNER:	description of formations encountered	from	to
<i>Jack Allen</i>			
(mailing address)	<i>Clay</i>	<i>0</i>	<i>18</i>
	<i>fine sand</i>	<i>18</i>	<i>38</i>
	<i>Sand</i>	<i>38</i>	<i>44</i>
	<i>Sand & gravel</i>	<i>44</i>	<i>113</i>
WELL LOCATION:			
sec. <i>13</i> T. <i>18</i> S. R. <i>4</i> E			
<i>2 1/2</i> miles <i>E</i> of <i>Inverness</i>			
(distance) (direction) (nearest town)			
WELL PURPOSE:			
(home, irrigation, municipal, industrial)			
WELL COMPLETION DATA:			
(1) diameter (inches) <i>16</i>			
(2) total depth (feet) <i>113</i>			
(3) static water level (feet) <i>18</i> below top of ground.			
(4) casing <i>Steel</i> <i>73</i> (material) (depth)			
<i>16</i> (size) if telescope see back.			
(5) screen <i>40</i> <i>73</i> (length) (depth to top)			
<i>16</i> (size) <i>Mild Steel</i> (material)			
(6) pump <i>40</i> <i>2000</i> (HP) (yield gpm)			
<i>electric</i> (type power)			
(7) electric log <i>No</i> (yes or no)			
(organization running log)			
(8) how well bottom plugged <i>Plate</i>			
DRILLERS REMARKS:			

DEPT. OF NATURAL RESOURCES
BUREAU OF LAND & WATER RESOURCES

SEP 30 1982
RECEIVED

If well telescopes please sketch and show depths.

GROUND LEVEL

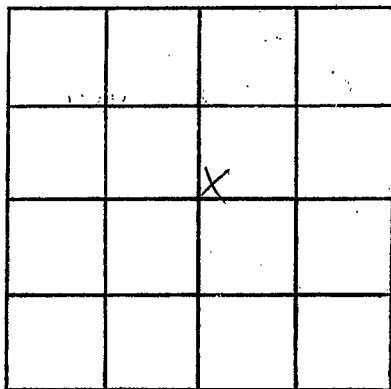

SECTION 13

Please indicate well location X.

ADDITIONAL INFORMATION

If more than one screen,
show locations of each on sketch.