

MISSISSIPPI DEPARTMENT OF NATURAL RESOURCES

Bureau of Land and Water Resources

Southport Mall

P.O. Box 10631

Jackson, Mississippi 39209

WATER WELL DRILLERS LOG

CODED

Sumflow
R77
5/14/82

5/14 1982
date well completed

Larry's well & pump
firm name

Sumflow
county well located

LANDOWNER: <u>Duncan Mc</u>	description of formations encountered	from	to
<u>Doverness mo.</u> (mailing address)	<u>slay</u> <u>met sand</u> <u>course S & gravel</u>	<u>0</u> <u>30</u> <u>50</u>	<u>30</u> <u>50</u> <u>102</u>
WELL LOCATION: sec <u>1</u> T <u>18</u> N R <u>4</u> E S <u>3</u> miles <u>West</u> of <u>mahesad</u> (distance) (direction) (nearest town)			
WELL PURPOSE: (home, irrigation, municipal, industrial)			
WELL COMPLETION DATA:			
(1) diameter (inches) <u>16"</u>			
(2) total depth (feet) <u>102'</u>			
(3) static water level (feet) <u>26</u> ^{below} / _{above} top of ground.			
(4) casing <u>Steel</u> , <u>62</u> (material) (depth)			
(size) If telescope see back.			
(5) screen <u>40</u> , <u>62'</u> (length) (depth to top)			
<u>16"</u> , <u>Steel</u> (size) (material)			
(6) pump <u>106</u> , <u>1600</u> (HP) (yield gpm)			
<u>D</u> (type power)			
(7) electric log <u>NO</u> (yes or no)			
(organization running log)			
(8) how well bottom plugged <u>Steel</u> <u>Plate</u>			
DRILLERS REMARKS:			


DEPT. OF NATURAL RESOURCES
BUREAU OF LAND & WATER RESOURCES

SEP 15 1982

RECEIVED

If well telescopes please sketch and show depths.

GROUND LEVEL

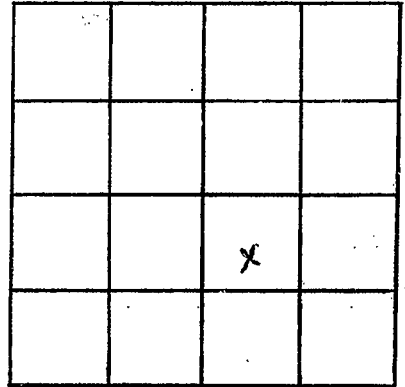

SECTION 1

Please indicate well location X.

ADDITIONAL INFORMATION

If more than one screen, show locations of each on sketch.