

MISSISSIPPI DEPARTMENT OF NATURAL RESOURCES

Bureau of Land and Water Resources

Southport Mall

P.O. Box 10631

Jackson, Mississippi 39209

WATER WELL DRILLERS LOG

CODED

SUNFLOWER
Q 79
11/13/83

Jan. 13 1983 date well completed
Larry's well pump firm name
Sunflower county well located

LANDOWNER:	description of formations encountered	from	to
Fieldland	clay	0	30
Shiveness mo (mailing address)	S Sand	30	100
WELL LOCATION:	Sand & gravel	100	170
sec. 8 T. 18 N. S. R. 4 E. W.	clay	170	230
3 miles S of Indianola	Sand & clay	230	500
(distance) (direction) (nearest town)	clay	500	680
WELL PURPOSE:	Fine Sand	680	1740
(home, irrigation, municipal, industrial)	coarse Sand	1740	1740
WELL COMPLETION DATA:			
(1) diameter (inches) 10" x 6"			
(2) total depth (feet) 790'			
(3) static water level (feet) 55' below top of ground.			
(4) casing 3" steel (material), 750' (depth)			
(size) If telescope see back.			
(5) screen 40' (length), 1750' (depth to top)			
6" (size), stainless (material)			
(6) pump 30 (HP), 500 (yield gpm)			
Electric (type power)			
(7) electric log NO (yes or no)			
(organization running log)			
(8) how well bottom plugged			

CODED

DEPT. OF NATURAL RESOURCES
BUREAU OF LAND & WATER RESOURCES


MAY 5 - 1983

RECEIVED

DRILLERS REMARKS:

If well telescopes please sketch and show depths.

GROUND LEVEL

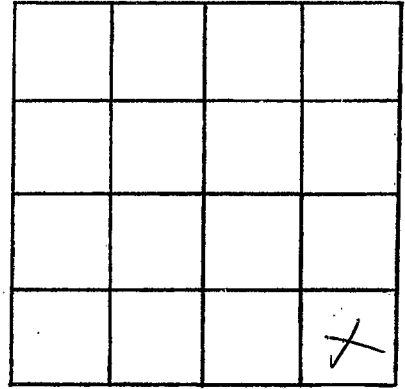

SECTION 8

Please indicate well location X.

ADDITIONAL INFORMATION

If more than one screen,
show locations of each on sketch.