

MISSISSIPPI DEPARTMENT OF NATURAL RESOURCES

Bureau of Land and Water Resources

Southport Mall

P.O. Box 10631

Jackson, Mississippi 39209

WATER WELL DRILLERS LOG

CODED

Q 81
 Sunflower
 CL-2554
 8-15-83

GW04287

8-15 1983 date well completed Sunflower firm name Sunflower county well located

LANDOWNER: City of Indianola, Ms
 (mailing address)

description of formations encountered	from	to
<u>clay</u>	<u>0</u>	<u>44</u>
<u>coarse sand</u>	<u>44</u>	<u>52</u>
<u>coarse sand/peg ground</u>	<u>52</u>	<u>72</u>
<u>coarse sand gravel</u>	<u>72</u>	<u>122</u>

WELL LOCATION:
 sec. 32 T 18 N R 4 E
inside city limits
 (distance) miles (direction) of (nearest town)

CODED

WELL PURPOSE:
 (home, irrigation, municipal, industrial)

WELL COMPLETION DATA:

(1) diameter (inches) 28"

(2) total depth (feet) 122'

(3) static water level (feet) 28' below above top of ground.

(4) casing steel 80'
 (material) (depth)
12" if telescope see back.
 (size)

(5) screen 40' 80'
 (length) (depth to top)
12" steel
 (size) (material)

(6) pump 30 800
 (HP) (yield gpm)
electric
 (type power)

(7) electric log no
 (yes or no)
 (organization running log)

(8) how well bottom plugged stagnate

DEPT OF NATURAL RESOURCES
 BUREAU OF LAND & WATER RESOURCES


OCT 10 1983

RECEIVED

DRILLERS REMARKS:

If well telescopes please
sketch and show depths.

GROUND LEVEL

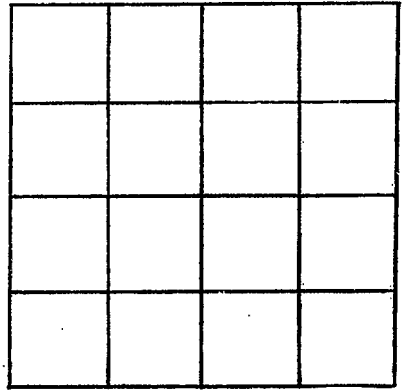

SECTION _____

Please indicate well location X.

ADDITIONAL INFORMATION

If more than one screen,
show locations of each on sketch.