

MISSISSIPPI DEPARTMENT OF NATURAL RESOURCES

Bureau of Land and Water Resources

Southport Mall

P.O. Box 10631

Jackson, Mississippi 39209

WATER WELL DRILLERS LOG CODED

Q82
 SUNFLOWER Co.
 2-25-81

2-25-81 date well completed 19 81 Larry's Well & Pump Service firm name county well located

LANDOWNER: Walter Fish Co
Indianola, Ms
 (mailing address)

description of formations encountered	from	to
clay	0	18
Broken Sand	18	30
med sand	30	50
coarse sand	50	100
Sand & gravel	100	130
clay	130	220
Sand	220	350
clay & sand	350	550
clay	550	680
sand	680	808

WELL LOCATION:
 sec 18 T B N R 4 E
S W
2 miles SE of Indianola
 (distance) (direction) (nearest town)

WELL PURPOSE: Fish Tank
 (home, irrigation, municipal, industrial)

WELL COMPLETION DATA: 200'-6"

- (1) diameter (inches) 6" x 4"
- (2) total depth (feet) 808'
- (3) static water level (feet) 20 below above top of ground.
- (4) casing steel (728' depth)
 (material) (depth)
 (size) if telescope see back.
- (5) screen 80 (728' length) (728' depth to top)
4" (sterless steel material)
 (size) (material)
- (6) pump 20 (250 yield gpm)
 (HP) (yield gpm)
Electric
 (type power)
- (7) electric log yes (yes or no)

CODED

DEPT. OF NATURAL RESOURCES
 BUREAU OF LAND & WATER RESOURCES

JAN 20 1981


RECEIVED

(organization running log)
 (8) how well bottom plugged Wash Valve

DRILLERS REMARKS:

If well telescopes please
sketch and show depths.

GROUND LEVEL

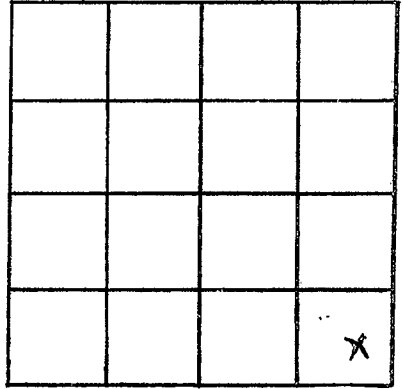

SECTION 3

Please indicate well location X.

ADDITIONAL INFORMATION

If more than one screen,
show locations of each on sketch.