

MISSISSIPPI DEPARTMENT OF NATURAL RESOURCES

Bureau of Land and Water Resources

Southport Mall

P.O. Box 10631

Jackson, Mississippi 39209

WATER WELL DRILLERS LOG

CODED

Sunflower
Q 6T
1-9-81
1-09-81

Q 83
GW 4876

Jan 09 1981 Larry Wells Pump Sunflower
date well completed year name county well located

LANDOWNER: Delta Fish
Indianola, MS.
(mailing address)

WELL LOCATION:
sec 27 T 18 N R 4 W
14 miles SE of Indianola
(distance) (direction) (nearest town)

WELL PURPOSE: Fish
(home, irrigation, municipal, industrial)

WELL COMPLETION DATA: 200'-6"

- (1) diameter (inches) 6" + 4"
- (2) total depth (feet) 800'
- (3) static water level (feet) 21 below top of ground.
- (4) casing steel 720'
(material) (depth)
(size) if telescope see back.
- (5) screen 80 720'
(length) (depth to top)
4" stainless
(size) (material)
- (6) pump 20 250
(HP) (yield gpm)
(type power)
- (7) electric log yes
(yes or no)
(organization running log)
- (8) how well bottom plugged _____

description of formations encountered	from	to
<u>slay</u>	<u>0</u>	<u>15</u>
<u>fine med sand</u>	<u>15</u>	<u>25</u>
<u>fine med sand</u>	<u>25</u>	<u>60'</u>
<u>coarse sand & gravel</u>	<u>60</u>	<u>100'</u>
<u>coarse sand & gravel</u>	<u>100</u>	<u>130</u>
<u>slay</u>	<u>130</u>	<u>220</u>
<u>med sand</u>	<u>220</u>	<u>355</u>
<u>slay</u>	<u>355</u>	<u>370</u>
<u>slay & sand streak</u>	<u>370</u>	<u>450</u>
<u>slay sand</u>	<u>450</u>	<u>480</u>
<u>slay</u>	<u>480</u>	<u>505</u>
<u>sand</u>	<u>505</u>	<u>540</u>
<u>slay</u>	<u>540</u>	<u>680</u>
<u>sand</u>	<u>680</u>	<u>800'</u>

CODED

DEPT. OF NATURAL RESOURCES
BUREAU OF LAND & WATER RESOURCES


JUN 3 - 1981

RECEIVED

DRILLERS REMARKS: _____

If well telescopes please sketch and show depths.

GROUND LEVEL

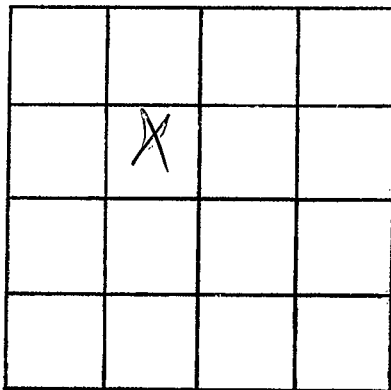

SECTION 33

Please indicate well location X.

ADDITIONAL INFORMATION

If more than one screen,
show locations of each on sketch.