

MISSISSIPPI DEPARTMENT OF NATURAL RESOURCES

Bureau of Land and Water Resources

Southport Mall

P.O. Box 10631

Jackson, Mississippi 39209

WATER WELL DRILLERS LOG

CODED

SUNFLOWER
Q 84
Gw 7088

April 13 1984 date well completed
Larri's Well's pump firm name
Sunflower county well located

LANDOWNER: Billy Stinson
Morehead, ms (mailing address)

description of formations encountered	from	to
slay	0	30
Fine Sand	30	60
Coarse Sand	60	112

WELL LOCATION:
sec. 1 T 18 N R 4 E
S W
3 miles WEST of Morehead
(distance) (direction) (nearest town)

WELL PURPOSE:
(home, irrigation, municipal, industrial)

- WELL COMPLETION DATA:
- (1) diameter (inches) 8"
 - (2) total depth (feet) 112'
 - (3) static water level (feet) 30' below top of ground.
 - (4) casing PVC, 72' (material) (depth)
(size) if telescope see back.
 - (5) screen 40' 72' (length) (depth to top)
8" PVC (size) (material)
 - (6) pump 1/2 (HP) 700 (yield gpm)
E (type power)
 - (7) electric log no (yes or no)
(organization running log)
 - (8) how well bottom plugged PVC cap

CODED

DEPT. OF NATURAL RESOURCES
BUREAU OF LAND & WATER RESOURCES


AUG 31 1984

RECEIVED

DRILLERS REMARKS:

If well telescopes please sketch and show depths.

GROUND LEVEL

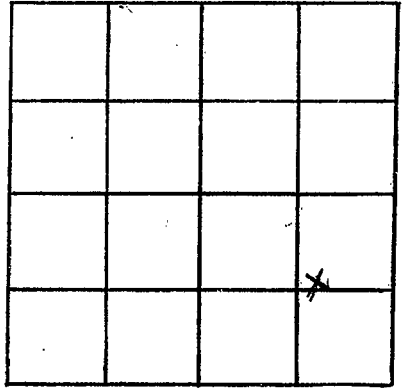

SECTION /

Please indicate well location X.

ADDITIONAL INFORMATION

If more than one screen,
show locations of each on sketch.