

MISSISSIPPI DEPARTMENT OF NATURAL RESOURCES

Bureau of Land and Water Resources

Southport Mall

P.O. Box 10631

Jackson, Mississippi 39209

WATER WELL DRILLERS LOG

CODED

SUNFLOWER

Q 85

April 13 1984
date well completed

Larry's Well Pump
firm name

Sunflower
county well located

LANDOWNER: Billy Stinson

description of formations encountered

from to

Morehead, Mo
(mailing address)

slay	0	30
fine sand	30	80
coarse sand	80	100

WELL LOCATION:

sec. 1 T 18 N R 4 E
S W
3 miles WEST of Morehead
(distance) (direction) (nearest town)

WELL PURPOSE:
(home, irrigation, municipal, industrial)

CODED

WELL COMPLETION DATA:

- (1) diameter (inches) 8"
- (2) total depth (feet) 100'
- (3) static water level (feet) 30' below top of ground.
- (4) casing PVC, 60' (material) (depth)
- (size) If telescope see back.
- (5) screen 40' 60' (length) (depth to top)
- 8" PVC (size) (material)
- (6) pump 10 (HP) 700 (yield gpm)
- E (type power)
- (7) electric log NO (yes or no)

(organization running log)

(8) how well bottom plugged PVC cap

DRILLERS REMARKS:


DEPT. OF NATURAL RESOURCES
BUREAU OF LAND & WATER RESOURCES

AUG 31 1984

RECEIVED

If well telescopes please sketch and show depths.

GROUND LEVEL

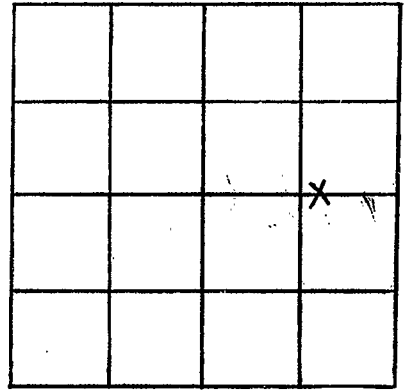

SECTION 1

Please indicate well location X.

ADDITIONAL INFORMATION

If more than one screen, show locations of each on sketch.