

**MISSISSIPPI DEPARTMENT OF NATURAL RESOURCES**  
**Bureau of Land and Water Resources**  
 Southport Mall  
 P.O. Box 10631  
 Jackson, Mississippi 39209  
**WATER WELL DRILLERS LOG**

**CODED**

SUNFLOWER  
Q86

April 13 1984 Larry's Well & Pump Sunflower  
 date well completed firm name county/well located

LANDOWNER: Billy Stinson  
Morehead Ms.  
 (mailing address)

description of formations encountered	from	to
<u>clay</u>	<u>0</u>	<u>30</u>
<u>Fine Sand</u>	<u>30</u>	<u>75</u>
<u>course Sand</u>	<u>75</u>	<u>120</u>

WELL LOCATION:  
 sec. 1 T. 18 N. R. 4 E.  
3 miles WEST of Morehead  
 (distance) (direction) (nearest town)

**CODED**

WELL PURPOSE:  
 (home, irrigation, municipal, industrial)

**WELL COMPLETION DATA:**

- (1) diameter (inches) 8"
- (2) total depth (feet) 120'
- (3) static water level (feet) 30 below above top of ground.
- (4) casing PVC, 80'  
 (material) (depth)  
 (size) if telescope see back.
- (5) screen 40', 80'  
 (length) (depth to top)  
8", PVC  
 (size) (material)
- (6) pump 10, 700  
 (HP) (yield gpm)  
E  
 (type power)
- (7) electric log no  
 (yes or no)  
 (organization running log)
- (8) how well bottom plugged PVC cap


DEPT. OF NATURAL RESOURCES  
 BUREAU OF LAND & WATER RESOURCES

**RECEIVED**  
 AUG 31 1984

DRILLERS REMARKS:

If well telescopes please sketch and show depths.

GROUND LEVEL

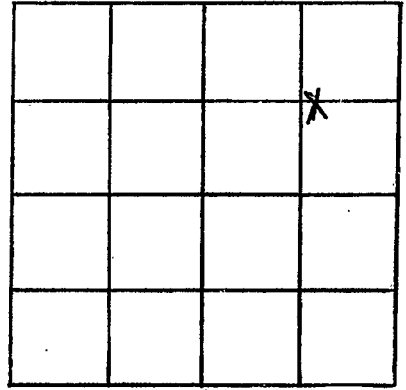

SECTION 1

Please indicate well location X.

ADDITIONAL INFORMATION

If more than one screen,  
show locations of each on sketch.