

MISSISSIPPI DEPARTMENT OF NATURAL RESOURCES

Bureau of Land and Water Resources

Southport Mall

P.O. Box 10631

Jackson, Mississippi 39209

WATER WELL DRILLERS LOG

CODED

SUNFLOWER
Q 87

7-21-84
date well completed

19 Irrigation Equipment
firm name

Sunflower
county well located

LANDOWNER: <u>George Scroggins</u> <u>Route 1, Box 734</u>	description of formations encountered	from	to
<u>Indianola, Mo. 65251</u> (mailing address)	CLAY	0	21
WELL LOCATION: sec. <u>11</u> T. <u>19</u> N R. <u>4</u> E <u>7 1/2</u> miles <u>SE</u> of <u>Indianola</u> (distance) (direction) (nearest town)	SAND AND GRAVEL	22	31
WELL PURPOSE: <u>IRRIGATION</u> (home, irrigation, municipal, industrial)	FINE SAND	32	70
WELL COMPLETION DATA: (1) diameter (inches) <u>60"</u>	COARSE SAND + GRAVEL	71	115
(2) total depth (feet) <u>115</u>			
(3) static water level (feet) <u>20</u> below above top of ground.			
(4) casing <u>PVC</u> <u>95'</u> (material) (depth)			
(5) screen <u>40</u> <u>95'</u> (length) (depth to top)			
<u>10"</u> <u>PVC</u> (size) (material)			
(6) pump <u>10</u> <u>1000</u> (HP) (yield gpm)			
(7) electric log <u>Elec.</u> (type power)			
(8) how well bottom plugged <u>PVC/AP</u>			
DRILLERS REMARKS:			

CODED


DEPT. OF NATURAL RESOURCES
BUREAU OF LAND & WATER RESOURCES

SEP - 4 1984

RECEIVED

If well telescopes please sketch and show depths.

GROUND LEVEL

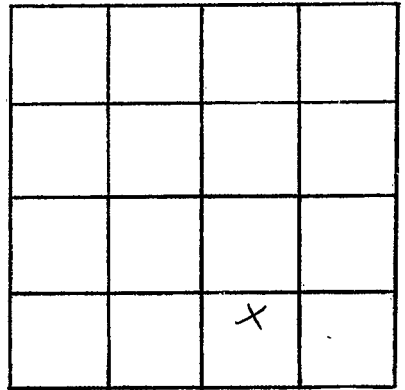

SECTION 11

Please indicate well location X.

ADDITIONAL INFORMATION

If more than one screen,
show locations of each on sketch.