

MISSISSIPPI DEPARTMENT OF NATURAL RESOURCES

Bureau of Land and Water Resources

Southport Mall

P.O. Box 10631

Jackson, Mississippi 39209

WATER WELL DRILLERS LOG

SUNFLOWER  
Q 90

CODED

7-9-84 19  
date well completed


IRRIGATION Equipment  
firm name

Sunflower  
county well located

LANDOWNER: <u>Seymour Johnson</u> <u>101 S. Sunflower Ave.</u> <u>Indianola, Mo. 63751</u> (mailing address)	description of formations encountered	from	to
WELL LOCATION: sec. <u>4</u> T. <u>18</u> (N) R. <u>4</u> E. (W) <u>3 1/4</u> miles <u>SE</u> of <u>Indianola</u> (distance) (direction) (nearest town)	Clay Sand Sand + gravel	6 27 58	26 57 95
WELL PURPOSE: <u>IRRIGATION</u> (home, irrigation, municipal, industrial)	CODED		
WELL COMPLETION DATA:			
(1) diameter (inches) <u>8"</u>			
(2) total depth (feet) <u>95'</u>			
(3) static water level (feet) <u>20</u> below top of ground.			
(4) casing <u>PVC</u> <u>55'</u> (material) (depth)			
(size) if telescope see back.			
(5) screen <u>40'</u> <u>55'</u> <u>8"</u> (length) (depth to top)			
(size) (material)			
(6) pump <u>25</u> <u>700</u> (HP) (yield gpm)			
<u>Elec.</u> (type power)			
(7) electric log _____ (yes or no)	DEPT. OF NATURAL RESOURCES BUREAU OF LAND & WATER RESOURCES		
(organization running log)	SEP - 4 1984		
(8) how well bottom plugged <u>PVC CAP</u>	RECEIVED		
DRILLERS REMARKS:			

If well telescopes please sketch and show depths.

GROUND LEVEL

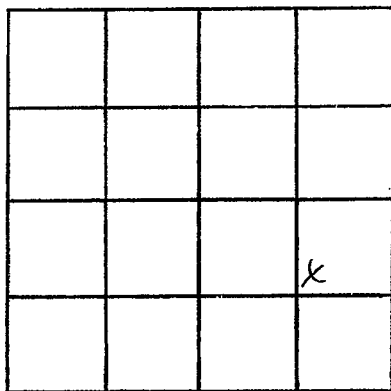

SECTION 4

Please indicate well location X.

ADDITIONAL INFORMATION

If more than one screen,  
show locations of each on sketch.