

MISSISSIPPI DEPARTMENT OF NATURAL RESOURCES

Bureau of Land and Water Resources

Southport Mall

P.O. Box 10631

Jackson, Mississippi 39209

WATER WELL DRILLERS LOG

CODED

SUNFLOWER

Q 91

7-6-84 19
date well completed

Irrigation Equipment Sunflower
firm name

county well located

LANDOWNER: Seymour Johnson
1015 Sunflower Ave.
Indianola, Mo. 65251
(mailing address)

description of formations encountered	from	to
Clay	0	26
Sand/Clay	26	35
Sand	36	58
Sand/gravel	59	96

WELL LOCATION:
sec. 4 T. 18 N. R. 4 E. S. W
3 1/2 miles SE of Indianola
(distance) (direction) (nearest town)

WELL PURPOSE: Irrigation
(home, irrigation, municipal, industrial)

- WELL COMPLETION DATA:
- (1) diameter (inches) 8"
 - (2) total depth (feet) 95'
 - (3) static water level (feet) 19' below top of ground.
 - (4) casing PVC 55'
(material) (depth)
 - (5) screen 40 55'
(size) (depth to top)
 - 8" (length) PVC
(size) (material)
 - (6) pump 25 700
(HP) (yield gpm)
 - Elec
(type power)
 - (7) electric log (yes or no) _____
 - (organization running log) _____
 - (8) how well bottom plugged PVC CAP

CODED

DEPT. OF NATURAL RESOURCES
BUREAU OF LAND & WATER RESOURCES


SEP - 4 1984

RECEIVED

DRILLERS REMARKS:

If well telescopes please sketch and show depths.

GROUND LEVEL

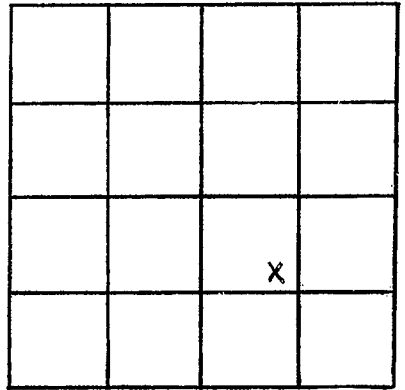

SECTION 4

Please indicate well location X.

ADDITIONAL INFORMATION

If more than one screen,
show locations of each on sketch.