

MISSISSIPPI DEPARTMENT OF NATURAL RESOURCES
 Bureau of Land and Water Resources
 Southport Mall
 P.O. Box 10631
 Jackson, Mississippi 39209
WATER WELL DRILLERS LOG

CODED

SUNFLOWER
Q92

7-1-84 19 IRrigation Equipment Sunflower
 date well completed firm name county well located

LANDOWNER: Seymour Johnson
101 S Sunflower Ave.
Indianola, Mo. 68751
 (mailing address)

description of formations encountered	from	to
Clay	0	22
Sand mixed clay	23	32
sand	33	72
Sand and gravel	73	115

WELL LOCATION:
 sec. 4 T. 18 N. R. 4 E.
3 miles SE of Indianola
 (distance) (direction) (nearest town)

WELL PURPOSE: Irrigation
 (home, irrigation, municipal, industrial)

WELL COMPLETION DATA:
 (1) diameter (inches) 8"
 (2) total depth (feet) 115
 (3) static water level (feet) 41 below
 top of ground.
 (4) casing PVC, 75'
 (material) (depth)
 (size) If telescope see back.
 (5) screen 40' 75'
 (length) (depth to top)
8" PVC
 (size) (material)
 (6) pump 25 700
 (HP) (yield gpm)
ELEC
 (type power)
 (7) electric log
 (yes or no)

 (organization running log)

(8) how well bottom plugged PVC CAP

DRILLERS REMARKS:

CODED


DEPT. OF NATURAL RESOURCES
 BUREAU OF LAND & WATER RESOURCES

SEP - 4 1984

RECEIVED

If well telescopes please sketch and show depths.

GROUND LEVEL

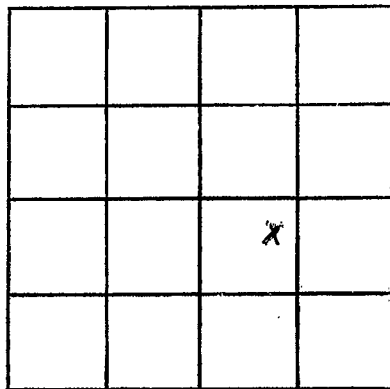

SECTION 4

Please indicate well location X.

ADDITIONAL INFORMATION

If more than one screen,
show locations of each on sketch.