

MISSISSIPPI DEPARTMENT OF NATURAL RESOURCES

Bureau of Land and Water Resources

Southport Mall

P.O. Box 10631

Jackson, Mississippi 39209

WATER WELL DRILLERS LOG

CODED

994
 SUNFLOWER
 10-28-84

June 28 1984 date well completed
 Larry's well & pump firm name
 Sunflower county well located

LANDOWNER: Joe Joe
 Inverness Ms
 (mailing address)

description of formations encountered	from	to
clay	0	30
Fine Sand	30	50
Coarse Sand	50	100

WELL LOCATION:
 sec. 32 T 18 N
 S 4 W
 3 miles W of Inverness
 (distance) (direction) (nearest town)

WELL PURPOSE:
 (home, irrigation, municipal, industrial)

- WELL COMPLETION DATA:
- (1) diameter (inches) 8"
 - (2) total depth (feet) 100'
 - (3) static water level (feet) 24' below top of ground
 - (4) casing PVC, 60' (material) (depth)
 (size) if telescope see back.
 - (5) screen 40' (length), 60' (depth to top)
 8" (size), PVC (material)
 - (6) pump 750/10 (HP), 700 (yield gpm)
 Electric (type power)
 - (7) electric log no (yes or no)

(organization running log)
 (8) how well bottom plugged PVC CAP

DRILLERS REMARKS:


DEPT. OF NATURAL RESOURCES
 BUREAU OF LAND & WATER RESOURCES

NOV 29 1984

RECEIVED

If well telescopes please sketch and show depths.

GROUND LEVEL

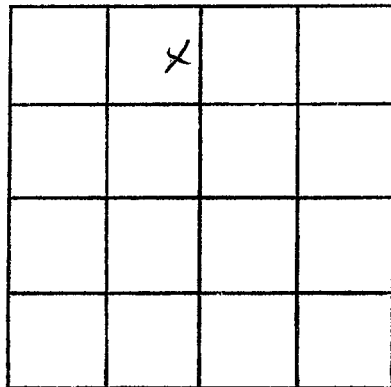

SECTION 32

Please indicate well location X.

ADDITIONAL INFORMATION

If more than one screen,
show locations of each on sketch.