

MISSISSIPPI DEPARTMENT OF NATURAL RESOURCES

Bureau of Land and Water Resources

Southport Mall

P.O. Box 10631

Jackson, Mississippi 39209

WATER WELL DRILLERS LOG

CODED

SUNFLOWER
Q97

1-3-86

date well completed

19 IRRIGATION EQUIPMENT

firm name

SUNFLOWER

county well located

LANDOWNER: L. K. AND S. B.

Johnson BOX 7

INDIANOLA, MS 38751

(mailing address)

description of formations encountered

from

to

Clay	0	20
Line	20	45
COURSE SAND / pea gravel	45	105

WELL LOCATION:

sec. 9 T. 18 (N) R. 4 (E)
S (W)
3 miles SOUTH of INDIANOLA
(distance) (direction) (nearest town)

WELL PURPOSE: PIVOT
(home, irrigation, municipal, industrial)

WELL COMPLETION DATA:

- diameter (inches) 8"
- total depth (feet) 105
- static water level (feet) 18 below above top of ground.
- casing PVC, 65,
(material) (depth)
8 if telescope see back.
(size)
- screen 40, 65
(length) (depth to top)
8, PVC
(size) (material)
- pump 30, 800
(HP) (yield gpm)
Electric
(type power)
- electric log NO
(yes or no)

(organization running log) PVC CAP

(8) how well bottom plugged PVC CAP

DRILLERS REMARKS:

CODED


RECEIVED
JAN 21 1986

Department of Natural Resources
Bureau of Land & Water Resources

If well telescopes please sketch and show depths.

IRRIGATION EQUIPMENT
G01/887-2555
INDIANOLA, MS

GROUND LEVEL

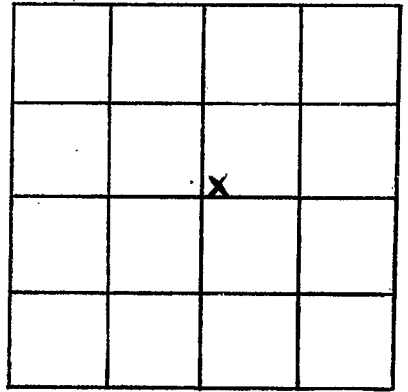

SECTION 9

Please indicate well location X.

ADDITIONAL INFORMATION

If more than one screen,
show locations of each on sketch.