

MISSISSIPPI DEPARTMENT OF NATURAL RESOURCES

Bureau of Land and Water Resources

Southport Mall

P.O. Box 10631

Jackson, Mississippi 39209

WATER WELL DRILLERS LOG

CODED

SUNFLOWER  
Q 98

12-31-85  
date well completed

IRRIGATION Equipment  
firm name

SUNFLOWER  
county well located

LANDOWNER: L.K. AND S.B. Johnson BOX 7  
INDIANOLA, MS 38751  
(mailing address)

description of formations encountered	from	to
Clay	0	15
fine sand	15	35
course sand/pea gravel	35	95

WELL LOCATION:  
sec. 10 T. 18 (N) R. 4 (E)  
3 miles South of Indianola  
(distance) (direction) (nearest town)

WELL PURPOSE: PIVOT  
(home, irrigation, municipal, industrial)

- WELL COMPLETION DATA:
- (1) diameter (inches) 8"
  - (2) total depth (feet) 95
  - (3) static water level (feet) 18 below above top of ground.
  - (4) casing PVC 55  
(material) (depth)
  - 8 if telescope see back.  
(size)
  - (5) screen 40 55  
(length) (depth to top)
  - 8 PVC  
(size) (material)
  - (6) pump 30 800  
(HP) (yield gpm)
  - Electric  
(type power)
  - (7) electric log NO  
(yes or no)
  - (organization running log) PVC CAP
  - (8) how well bottom plugged PVC CAP

CODED

RECEIVED  
JAN 21 1986


Department of Natural Resources  
Bureau of Land & Water Resources

DRILLERS REMARKS:

If well telescopes please sketch and show depths.

IRRIGATION EQUIPMENT  
601/887-2555  
INDIANOLA, MS

GROUND LEVEL

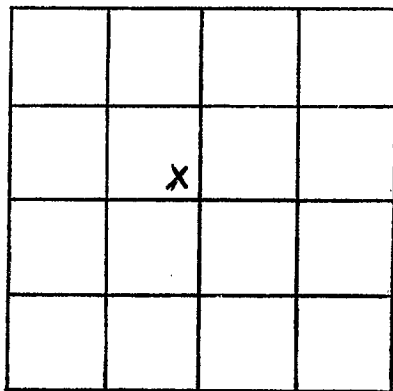

SECTION 10

Please indicate well location X.

ADDITIONAL INFORMATION

If more than one screen,  
show locations of each on sketch.