

☐
Sunflower
Q 99
☐

MISSISSIPPI DEPARTMENT OF NATURAL RESOURCES

Bureau of Land and Water Resources

Southport Mall

P.O. Box 10631

Jackson, Mississippi 39209

WATER WELL DRILLERS LOG

CODED

June 05 1985 date well completed Larry's well & pump Sunflower county well located

LANDOWNER: George Baird, Jr. Inc.

description of formations encountered

from

to

Lawrence, Mo
(mailing address)

CLAY 0 40
FINE SAND 40 64
COARSE SAND & GRAVEL 64 116

WELL LOCATION:

sec. 28 T 18 N R 4 E
S 4 W
3 miles North of Lawrence
(distance) (direction) (nearest town)

CODED

WELL PURPOSE:

(home, irrigation, municipal, industrial)

WELL COMPLETION DATA:

- (1) diameter (inches) 12"
(2) total depth (feet) 116'
(3) static water level (feet) 22' below
top of ground.
(4) casing Steel 76'
(material) (depth)
(size) If telescope see back.
(5) screen 40' 76'
(length) (depth to top)
12" Steel
(size) (material)
(6) pump 80 1300
(HP) (yield gpm)
0
(type power)
(7) electric log no
(yes or no)

(organization running log)

(8) how well bottom plugged Steel Plate


DRILLERS REMARKS:

RECEIVED
FEB 18 1986

Department of Natural Resources
Bureau of Land & Water Resources

If well telescopes please sketch and show depths.

GROUND LEVEL

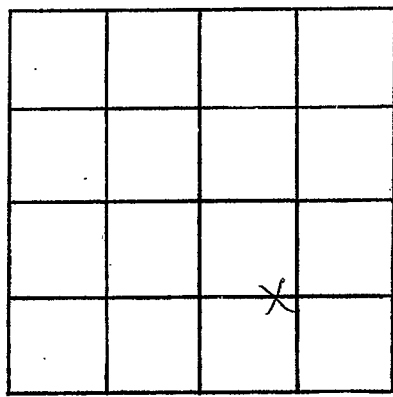

SECTION 28

Please indicate well location X.

ADDITIONAL INFORMATION

A series of horizontal lines for writing additional information.

If more than one screen, show locations of each on sketch.