

MISSISSIPPI DEPARTMENT OF NATURAL RESOURCES

Bureau of Land and Water Resources

Southport Mall

P.O. Box 10631

Jackson, Mississippi 39209

WATER WELL DRILLERS LOG

CODED

Surflower
Q 100

June 06 1985 date well completed Larry's well & pump firm name Surflower county well located

LANDOWNER: George Baird, Jr.
Inveness, Mo.
 (mailing address)

description of formations encountered	from	to
CLAY	0	30
FINE SAND	30	54
COARSE SAND & GRAVEL	54	116

WELL LOCATION:
 sec. 28 T 18 N R 4 E
3 miles N of Inveness
 (distance) (direction) (nearest town)

CODED

WELL PURPOSE:
 (home, irrigation, municipal, industrial)

WELL COMPLETION DATA:

(1) diameter (inches) 12"

(2) total depth (feet) 116'

(3) static water level (feet) 26' ^{below}/_{above} top of ground.

(4) casing Steel, 76',
 (material) (depth)
 (size) If telescope see back.

(5) screen 40', 76'
 (length) (depth to top)
12", Steel
 (size) (material)

(6) pump 80 1300
 (HP) (yield gpm)
D
 (type power)

(7) electric log NO
 (yes or no)
 (organization running log)


(8) how well bottom plugged Steel Plate

RECEIVED
 FEB 18 1986

DRILLERS REMARKS:

If well telescopes please sketch and show depths.

GROUND LEVEL

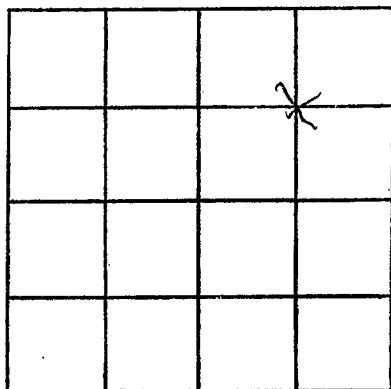

SECTION 28

Please indicate well location X.

ADDITIONAL INFORMATION

If more than one screen,
show locations of each on sketch.