

MISSISSIPPI DEPARTMENT OF NATURAL RESOURCES

Bureau of Land and Water Resources

Southport Mall

P.O. Box 10631

CODED

Jackson, Mississippi 39209

WATER WELL DRILLERS LOG

SUNFLOWER
 103
 4-27-86

4-27-86
 date well completed

IRRIGATION EQUIPMENT
 firm name

SUNFLOWER
 county well located

LANDOWNER: PEARSON'S
 NURSEY BAYOU DR.
 INDIANOLA, MS 38751
 (mailing address)

description of formations encountered	from	to
clay	0	15
fine sand	15	25
coarse sand / pea gravel	25	97

WELL LOCATION:
 sec. 33 T. 18 N. R. 4 E
 2 miles EAST of INDIANOLA
 (distance) (direction) (nearest town)

WELL PURPOSE: TREES
 (home, irrigation, municipal, industrial)

WELL COMPLETION DATA:

(1) diameter (inches) 8"

(2) total depth (feet) 97'

(3) static water level (feet) 30' below top of ground.

(4) casing PVC 57' (material), (depth)
 8" (size) if telescope see back.

(5) screen 40' 57' (length), (depth to top)
 8" (size), PVC (material)

(6) pump 10 (HP) 600 (yield gpm)
 Electric (type power)

(7) electric log NO (yes or no)

(organization running log)

(8) how well bottom plugged PVC CAP

DRILLERS REMARKS:
 # 86115KSE02


RECEIVED
 MAY 6 1986

Department of Natural Resources
 Bureau of Land and Water Resources

If well telescopes please sketch and show depths.

IRRIGATION EQUIPMENT, INC.
P.O. BOX 708
INDIANOLA, MS 38751

GROUND LEVEL

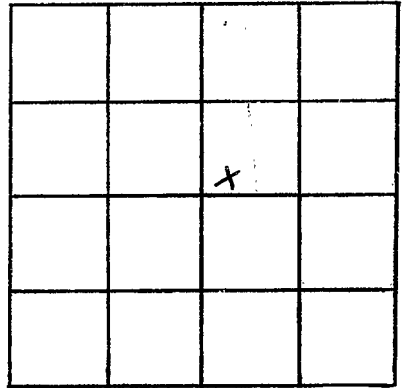

SECTION 33

Please indicate well location X.

ADDITIONAL INFORMATION

If more than one screen,
show locations of each on sketch.