

MISSISSIPPI DEPARTMENT OF NATURAL RESOURCES

Bureau of Land and Water Resources

Southport Mall

P.O. Box 10631

Jackson, Mississippi 39209

WATER WELL DRILLERS LOG

CODED

SUNFLOWER
Q104
GW 4575

9-6 1986 J & K INVESTIGATORS SUNFLOWER
 date well completed firm name county well located

LANDOWNER: DELTA CATFISH
Prosserons. PO Box 850
Indianola, Miss
 (mailing address)

WELL LOCATION:
 sec. 4 T. 18 N R. 4 E
 & W
3 miles E of Indianola
 (distance) (direction) (nearest town)

WELL PURPOSE: INDUSTRIAL
 (home, irrigation, municipal, industrial)


WELL COMPLETION DATA:

- (1) diameter (inches) 12" x 6"
- (2) total depth (feet) 810
- (3) static water level (feet) 27 below above top of ground.
- (4) casing Steel 418
 (material) (depth)
12" if telescope see back.
 (size)
- (5) screen 80 730
 (length) (depth to top)
6 STAINLESS STEEL
 (size) (material)
- (6) pump 30 500
 (HP) (yield gpm)
Electric
 (type power)
- (7) electric log NO
 (yes or no)

(organization running log)

(8) how well bottom plugged BACK
WASH WATER

description of formations encountered	from	to
CLAY	0	17
SAND	17	46
COARSE SAND & GRAVEL	46	142
CLAY	142	149
SAND	149	253
CLAY	253	278
SAND	278	429
CLAY & SAND ST.	429	462
SAND	462	543
CLAY	543	548
SAND	548	572
CLAY	572	583
SAND CODED	583	602
CLAY	602	647
SAND	647	671
ROCK	671	676
CLAY & SAND ST.	676	680
SAND	680	815

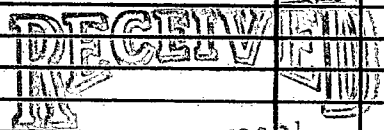


SEP 19 1986

Department of Natural Resources
 Bureau of Land & Water Resources

DRILLERS REMARKS:

If well telescopes please sketch and show depths.

GROUND LEVEL

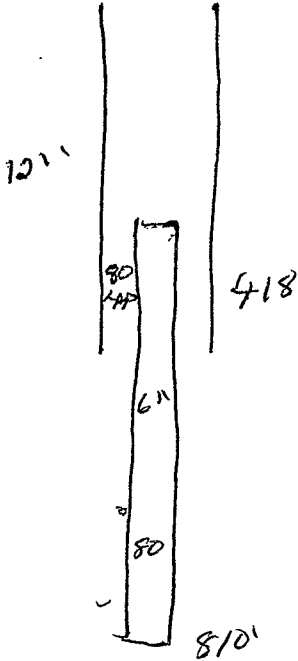

			X

SECTION 4

Please indicate well location X.

ADDITIONAL INFORMATION

If more than one screen, show locations of each on sketch.