

MISSISSIPPI DEPARTMENT OF NATURAL RESOURCES

Bureau of Land and Water Resources

Southport Mall

P.O. Box 10631

Jackson, Mississippi 39209

WATER WELL DRILLERS LOG

Sunflower
Q 113
147A

Caled

8-24

1987

J & K HASTIE

Sunflower

date well completed

firm name

county well located

LANDOWNER:

DELTA CATFISH PHOS

description of formations encountered

from

to

INADOLA, MISS

(mailing address)

WELL LOCATION:

sec. 17 T. 18 N. R. 4 W
2 miles S of Inadola
 (distance) (direction) (nearest town)

CLAY	0	18
SAND	18	46
SAND & GRAVEL	46	169
CLAY	169	270
SAND	270	560
CLAY	560	686
SAND	686	847

WELL PURPOSE:


Industrial
 (home, irrigation, municipal, industrial)

WELL COMPLETION DATA:

- (1) diameter (inches) 12" x 6"
- (2) total depth (feet) 827'
- (3) static water level (feet) 22 below above top of ground.
- (4) casing Steel 315'
 (material) (depth)
12" If telescope see back.
 (size)
- (5) screen 80' 747'
 (length) (depth to top)
6" S.S. Steel
 (size) (material)
- (6) pump 30 500
 (HP) (yield gpm)
Electric
 (type power)
- (7) electric log NO.
 (yes or no)

(organization running log)

(8) how well bottom plugged U/Alve

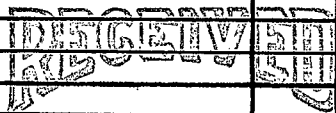

NOV 12 1987

Department of Natural Resources
 Bureau of Land & Water Resources

DRILLERS REMARKS:

