

MISSISSIPPI DEPARTMENT OF NATURAL RESOURCES

Bureau of Land and Water Resources

Southport Mall

P.O. Box 10631

Jackson, Mississippi 39209

WATER WELL DRILLERS LOG

JEP  
87217-DCP-01  
①115

1478 1987 Dyer Well Sunflower  
date well completed firm name county well located

LANDOWNER: Maxwell Fish Farm  
Box 129  
Inverness Ms.  
(mailing address)

description of formations encountered	from	to
CLAY	0	35
Sand & Gravel	35	42
Clay & Fine Sand	42	72
Sand & Gravel	72	118

WELL LOCATION:  
sec 21 T 18 N R 4 E  
3 miles N of Inverness  
(distance) (direction) (nearest town)

WELL PURPOSE: Fish Sands  
(home, irrigation, municipal, industrial)

- WELL COMPLETION DATA:
- (1) diameter (inches) 16"
  - (2) total depth (feet) 118'
  - (3) static water level (feet) \_\_\_\_\_ below/above top of ground.
  - (4) casing steel (material), \_\_\_\_\_ (depth),  
16" (size) if telescope see back.
  - (5) screen 40' (length), \_\_\_\_\_ (depth to top),  
16" (size), \_\_\_\_\_ (material)
  - (6) pump 40 (HP), 2000 (yield gpm)  
Electric (type power)
  - (7) electric log No (yes or no)  
None (organization running log)
  - (8) how well bottom plugged Plate

RECEIVED


OCT 20 1987

Department of Natural Resources  
Bureau of Land & Water Resources

DRILLERS REMARKS:

If well telescopes please  
sketch and show depths.

GROUND LEVEL

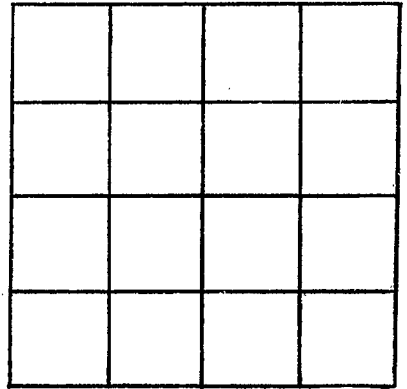

SECTION \_\_\_\_\_

Please indicate well location X.

ADDITIONAL INFORMATION

If more than one screen,  
show locations of each on sketch.