

MISSISSIPPI DEPARTMENT OF NATURAL RESOURCES

Bureau of Land and Water Resources

Southport Mall

P.O. Box 10631

Jackson, Mississippi 39209

WATER WELL DRILLERS LOG

JEP  
87217-DCP-02  
~~Sumner~~  
Q 116

Caled

1478 1987 Dyer Well Sumner  
date well completed firm name county well located

LANDOWNER: MAXWELL FISH  
Box 129  
FARM

description of formations encountered	depth	
	from	to
<u>CLAY</u>	<u>0</u>	<u>30</u>
<u>Fine Sand</u>	<u>30</u>	<u>72</u>
<u>Sand &amp; Gravel</u>	<u>72</u>	<u>118</u>

Inverness Ms.  
(mailing address)

WELL LOCATION:  
sec. 21 T. 18 N R. 4 E  
3 miles N of Inverness  
(distance) (direction) (nearest town)

WELL PURPOSE: Fish Ponds  
(home, irrigation, municipal, industrial)

WELL COMPLETION DATA:

- (1) diameter (inches) 16"
- (2) total depth (feet) 118'
- (3) static water level (feet) \_\_\_\_\_ below above top of ground
- (4) casing steel \_\_\_\_\_ (material) (depth)
- 16" If telescope see back. (size)
- (5) screen 40' \_\_\_\_\_ (length) (depth to top)
- 16" \_\_\_\_\_ (size) (material)
- (6) pump 40 2000 \_\_\_\_\_ (HP) (yield gpm)
- Electric (type power)
- (7) electric log No \_\_\_\_\_ (yes or no)
- None \_\_\_\_\_ (organization running log)
- (8) how well bottom plugged Plate

RECEIVED


OCT 20 1987

DRILLERS REMARKS:

Department of Natural Resources  
Bureau of Land and Water Resources

If well telescopes please  
sketch and show depths.

GROUND LEVEL

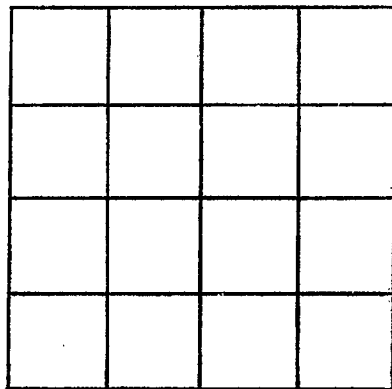

SECTION \_\_\_\_\_

Please indicate well location X.

ADDITIONAL INFORMATION

If more than one screen,  
show locations of each on sketch.