

MISSISSIPPI DEPARTMENT OF NATURAL RESOURCES

Bureau of Land and Water Resources
 P.O. Box 10631
 Jackson, Mississippi 39209

COUNTY WELL LOCATED
Sunflower

WELL NUMBER
Q 117

DATE WELL COMPLETED
3-06-87

PERMIT NUMBER
MS-GW-07215

NAME OF DRILLING FIRM
Larry's well & pump

DEC 3 1987
 WATER WELL DRILLERS LOG

NAME & MAILING ADDRESS OF LANDOWNER
Charlie W. King, Jr.
P.O. Box 63
Inverness MS

WELL LOCATION: SEC **33** TOWNSHIP **18** RANGE **4**

DISTANCE **2** Miles DIRECTION **WEST** NEAREST TOWN **Inverness**

OTHER LANDMARK

WELL PURPOSE: Home, Irrigation, Municipal, Industrial, Fish Pond, etc.

PUMP TYPE (Circle One):
 Submersible, Turbine, Jet, Flowing Well,
 Other (Describe)

POWER TYPE (Circle One):
 Electric, Tractor, Diesel, Gasoline, Butane,
 Other (Describe)

Pump Capacity (GPM)	No. of Stages	Setting Depth
1000	3	60 FT.

PUMP TEST

Well yielded _____ GPM with
 a drawdown of _____ ft.
 after _____ hours of pumping

WELL DATA

Well Depth 116'	Casing Diameter (In.) 16"	Casing Length (Ft.) 76'
Type of Casing Steel	Hole Depth 116'	Depth to Static Water Level 23'

TYPE OF COMPLETION: (Circle One or More):
Gravel Packed, Underreamed, Telescoped,
 Natural Development, Open Hole, Other

Top of Lap Pipe or Reduction in Casing

FEET IF TELESCOPED OR MORE THAN ONE SCREEN: USE BACK PAGE

LOG DATA

TYPE OF LOG RUN (Circle One):
 Electric, Gamma Ray, Density, Sonic, No Log Run, Neutron,
 Other (Describe)

Name of Organization Running Log

SCREEN DATA

Diameter - Inches 16"	Length - Feet 40'	Slot Size - Inches .060
Screen Type Steel	Depth to Bottom - Feet 116'	

GEOLOGIC DATA (Office Use Only)

Surface Elev.	Geologic Unit	Unit Thickness	Depth to Top
Subs. SWL	Date	Analysis	Aquifer Test


Driller's Remarks

DESCRIPTION OF FORMATIONS ENCOUNTERED	FROM	TO	FORMATIONS (Continued)	FROM	TO
Clay	0	32			
fine sand	32	65			
coarse sand	65	116			

IF MORE SPACE IS NEEDED, USE BACK

If well telescopes please sketch and show depths.

GROUND LEVEL

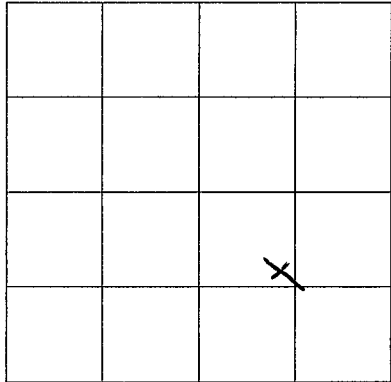

SECTION 33

Please indicate well location X.

ADDITIONAL INFORMATION

A series of horizontal lines for writing additional information.

If more than one screen, show location of each on sketch.