|   |                         | State W                   | ell Report  | For Office Use Only:             |
|---|-------------------------|---------------------------|---|----------------------------------|
| County: sunflo                            | wer 133                 | P                         | Part 1  | _                                |
| Permit #: GW L                            | 10136                   | Mississippi Departmen     | art 1<br>at of Environmental Quality<br>and Water Resources | Aquifer:                         |
| Irrigation                                | Equipment #             | <b>nc</b> P.O. I          | Box 10631   | won w.                           |
|   |                         | Jackson, N                | AS 39289-0631   | L. S. Elevation:                 |
| Date drilling completed: 4-21-05 (601)354 |                         |                           | 4-6938 (fax)  | E-log #:                         |
| State Law requ                            | ires that this repo     | ort be prepared by the    | driller in detail and filed w                               | ith the Department within        |
|   | pletion of drilling     |                           | Well  | Location                         |
| Goo                                       | se Pond Ag              |                           | 7 (4-1  | " Longitude:°'"                  |
| Owner Name C/O                            | New South               | Properties                |   |                                  |
| Mailing Address: 3                        |                         | alia Road                 | Method of Lat/Long (circle or                               | ne): Conventional Survey,        |
| S   | uite 203                |                           | USGS quad, Hand-held  | GPS, Survey-grade GPS            |
|   |                         | ·                         | SE 1/4 SE 1/4 Sec 23  | 3 Twn 18N Rng 4W                 |
| City                                      | ollierville<br>Stat     | e, TN 38017               | Distance Direction  | Nearest Town                     |
| •   |                         |                           |   | of <u>Inverness</u>              |
| Telephone No. (                           | )                       | <del> </del>              |   |                                  |
|   |                         | Well                      | Data  |                                  |
| Purpose of Well (circl                    | e one) Home Indi        | ustrial Public Supply     | rigation Fish Culture                                       | Other:                           |
| -   |                         |                           | well drilling completed:                                    | 4-21-05_                         |
|   |                         |                           |   |                                  |
|   |                         |                           | describe)   |                                  |
| Static Water Level:                       | 35 feet ab              | ove or below (circle one) | land surface Date measured:                                 | 4-22-05                          |
| Method of Measureme                       | ent (circle one)        | eel tape electric tap     | e air line other:   |                                  |
| Hole depth: 127                           | Weil der                | oth: 127'                 | _ Well grouted to a depth of _                              | 10 feet                          |
| Type of grout (circle                     | one): Cement            | Bentonite Mix             | \$  |                                  |
| Casing length: 8                          | 7 feet Casin            | ng diameter. 16           | inches Type of casing: _                                    | PVC Sch. 40                      |
| Screen length:4                           | O feet Scre             | en diameter: 16           | inches Type of screen: _                                    | PVC Sch.40                       |
| Screen slot size: • 0                     | 50 inches               | Setting depth: From       | 88 feet to  | 127 feet                         |
| Type of completion (                      | circle all applicable): | Grevel packed Und         | erreamed Telescoped Ope                                     | n hole Natural Development       |
|   |                         | Other (describe):         |   |                                  |
| Top of lap pipe or red                    | luction in casing:      | feet. If t                | telescoped or more than one so                              | reen, describe on back of page   |
| Logs run (circle all ap                   | oplicable). No log ru   | n Electric Gamma Ra       | y Density Sonic Neutron                                     | Other:                           |
| Name of organization                      | running log(s):         |                           |   |                                  |
| T   |                         | .4.11                     | accordance with all applicable                              | e requirements of the Mississipp |
| 1   |                         |                           |   |                                  |
| 1   |                         |                           | epartment of Health regulatio                               |                                  |

Print Name of Water Well Contractor and License No.

**RECEIVED** 

Signature of Water Well Contractor


MAY 1 3 2005

If well telescopes please sketch below and show depths.

Ground Level

| Description of Formations Encountered | From _   | To       |
|---------------------------------------|----------|----------|
|                                       | 0        | 35       |
| Fine Sand                             | 36       | 45       |
| Clay<br>Fine Sand<br>Med. Sand        | 46       | 75       |
| Coarse Sand                           | 76       | 85       |
| Coarse Sand/gravel                    | 86       | 127      |
|                                       | L        |          |
|                                       | <u> </u> | $\perp$  |
|                                       | <u> </u> | <b> </b> |
|                                       |          | 1        |
|                                       | ļ        | 1        |
|                                       |          |          |
|                                       |          | 1        |
|                                       |          |          |
|                                       | <u> </u> |          |
|                                       |          | 11       |
|                                       |          | $\perp$  |
|                                       |          | 1        |
|                                       |          |          |
|                                       |          | $\perp$  |
|                                       |          | 4        |
|                                       |          |          |
|                                       |          | $\perp$  |
|                                       |          | 4        |
|                                       |          |          |

If more than one screen, show location of each on sketch

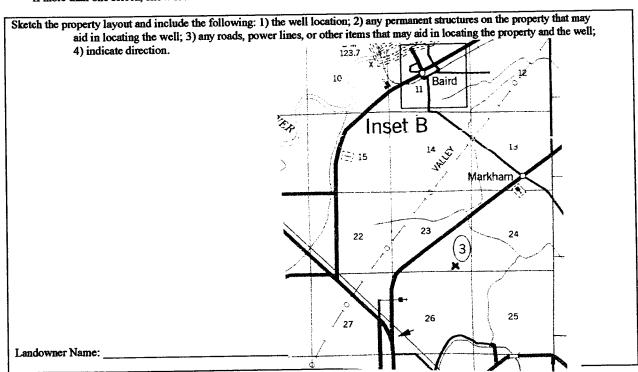

Signature of Water Well Contractor

## STATE WELL REPORT

Part 2 Sunflower **Pump Installer's Completion Report** County: Mississippi Department of Environmental Quality Office of Land and Water Resources Irrigation P.O. Box 10631 Driller: Jackson, MS 39289-0631 4-22-05 (601)961-5210 Date completed: (601)354-6938 (fax)

| For Office Use Only: |  |  |
|----------------------|--|--|
| Aquifer:             |  |  |
| Well#: Q W           |  |  |
| Elevation:           |  |  |

| This report sh<br>installation of   |          | oy the pump installer in deta                                 | ail and filed with the Department within 30 days of the  |
|---|----------|---|--|
| Well Owner Information Goose Pond AG Owner Name: C/O New South Properties                                     |          |   | Well Location  Latitude: Longitude:  |
| Mailing Address: 362 New Byhalia Road  Collierville, TN 38017 City State Zip Code  901-854-4649 Telephone No. |          |   | Method of Lat/Long (circle one): Conventional Survey,  |
|   |          |   | USGS quad, Hand-held GPS, Survey-grade GPS           SE         1/4         Sec         23         Twn         18N         Rng         4W           Distance         Direction         Nearest Town           3         Miles         North of Inverness |
| Pump Type Circle one  |          |   | Power Type Circle one  |
| Air Lift  | Jet      | Submersible   | Diesel Engine Gasoline Engine Natural Gas  |
| Bucket  | Piston   | Turbine   | Electric Motor Hand Tractor PTO  |
| Centrifugal   | Rotary   | Flowing Well  | Windmill Other (specify):  |
| Other (specify):  |          |   | Horse Power Rating of Motor: 60  |
| Date Pump Installed   | d:       | 4-22-05   | Setting Depth: 70 feet   |
| Rated Pump Capacity:Gallons Per Minute  |          |   | Number of Stages:1   |
| Pump Test Data  Date Well Tested:  Static Water Level (A):  Pumping Water Level (B):  Feet Below Land Surface |          |   | Method of Measuring Water Level Circle one   |
|   |          |   | Air Line Electric Measuring Line Steel Tape  Other (specify):  |
| Drawdown [(B) - (A)]:Feet Below Land Surface  |          |   | For flowing well, measured shut in head:feet   |
| Test Pumping Rate:Gallons Per Minute  |          |   | Well yieldedGPM with a drawdown of   |
| Duration of Pump Test (minimum 4 hours):hours   |          |   | feet afterhours of pumping   |
| Patrick   | M. Chism | atements are true to the best of 0695 use No. (if applicable) | of my knowledge.  Turis, M Churn  Signature of Pump Installer  |

RECEIVED

MAY 13 2005

BY: OLWR